

Name **Duffy Const. Co.**

Service No.

Address ~~XXXXXXXXXXXXXXXXXXXX~~ 35 Philip Road

Lot #220 **35 Philip Road**

Location

Kind of Pipe **John J. Flannery Permit #A84**

Size **6"**

Size of Main **8"**

~~Repair~~ ~~Reservoir~~ **New Service**

Location


Date	Material	Amount	Total	Date	Amount
8/66	68' 6" Transite pipe				

DATE _____

TOWN OF LEXINGTON — BOARD OF PUBLIC WORKS

SEWER DIVISION

Sketch of Service Here **35**

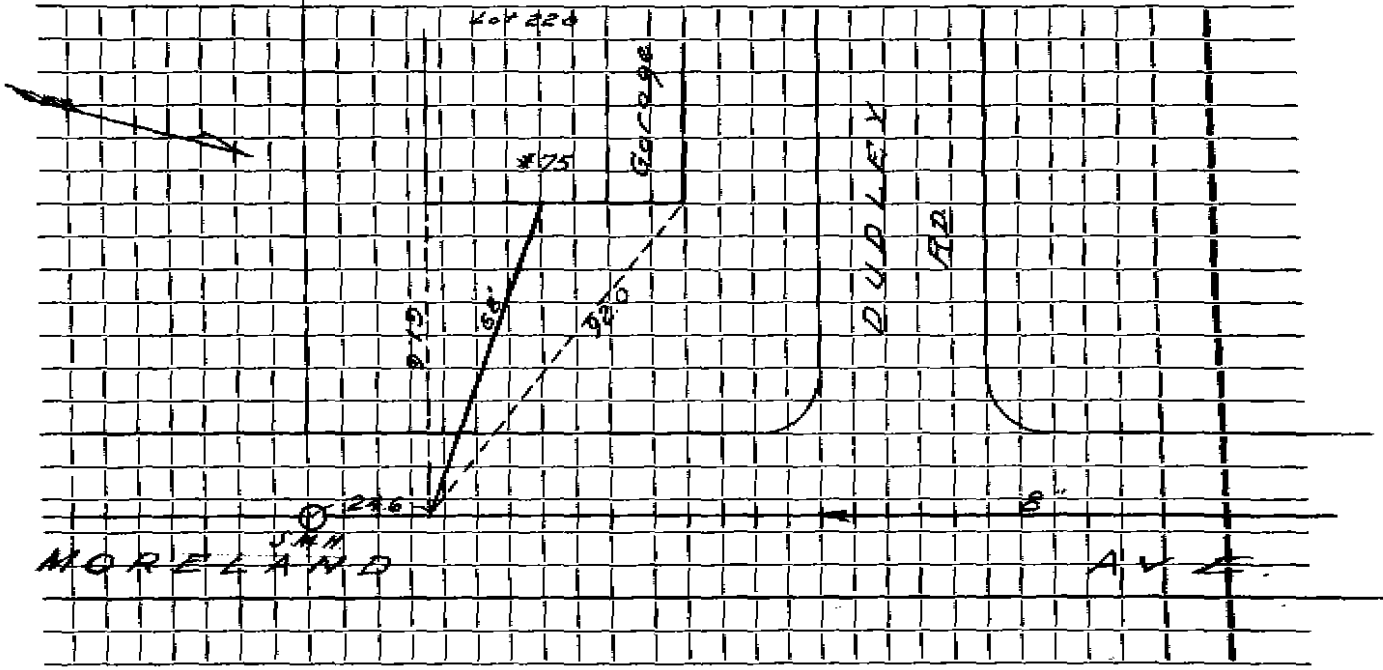

Connection made in Street. Work completed

Remarks:
.....
.....