

Name Buffy Const. Co.

Service No.

Address ~~160 Moreland Avenue~~ 36 Philip Road

Lot 197 36 Philip Road Location

Kind of Pipe John J. Flannery Permit #A90

Size 6"

Size of Main 8"

~~Service Break~~ New Service

Location

Date		Material	Amount		Total	Date		Amount	
<u>13/66</u>	<u>53'</u>	<u>6" Transite pipe</u>							


DATE \_\_\_\_\_

TOWN OF LEXINGTON — BOARD OF PUBLIC WORKS

SEWER DIVISION

Sketch of Service Here

**36**

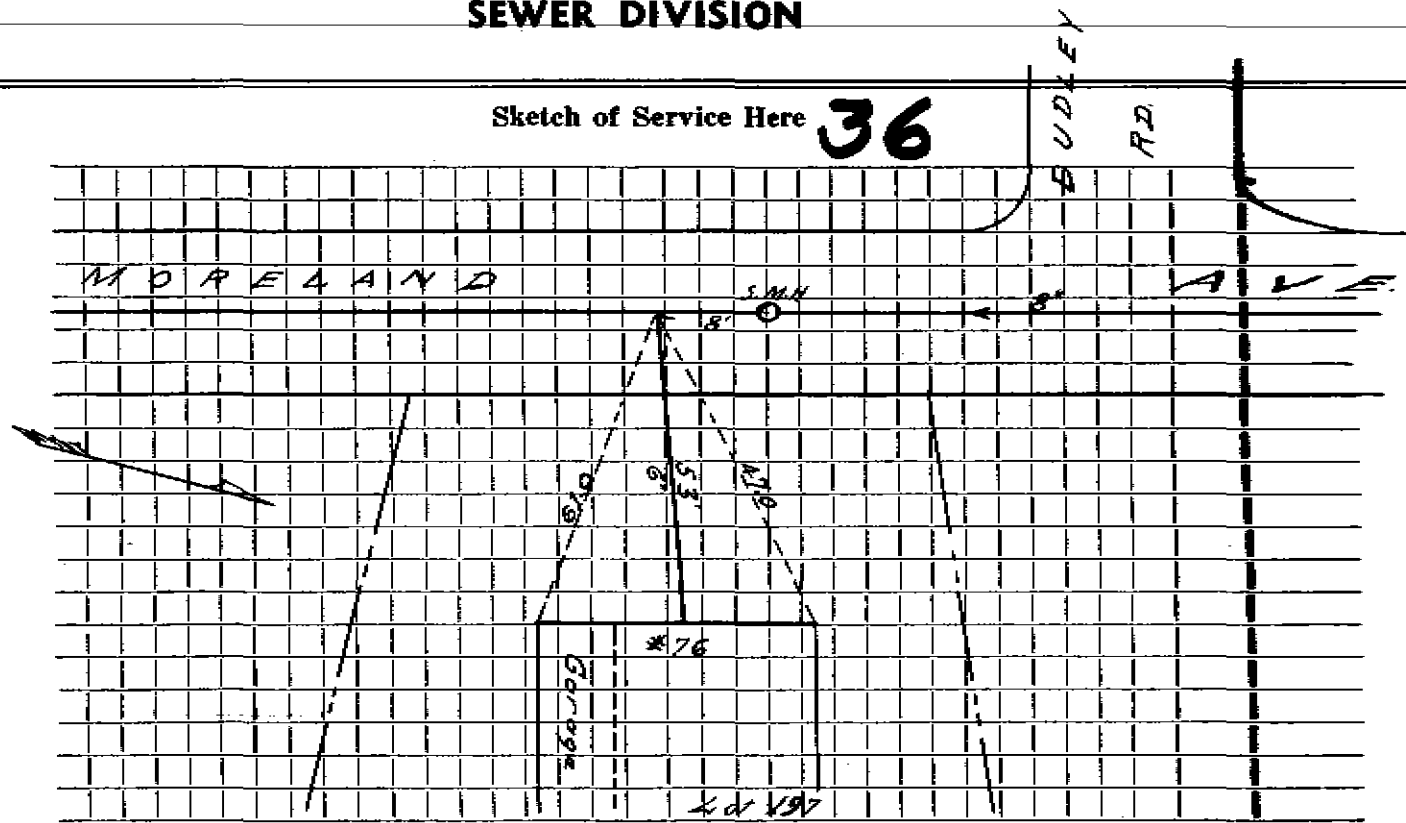

Connection made in ..... Street. Work completed .....

Remarks: .....  
.....  
.....