

DATE 8/31/95


TOWN OF LEXINGTON — BOARD OF PUBLIC WORKS

SEWER DIVISION

SEWER MAIN
5" x 19" SMO
6" x 18" SMO
5" x 15" SMO
Sched 40

Sketch of Service Here

16

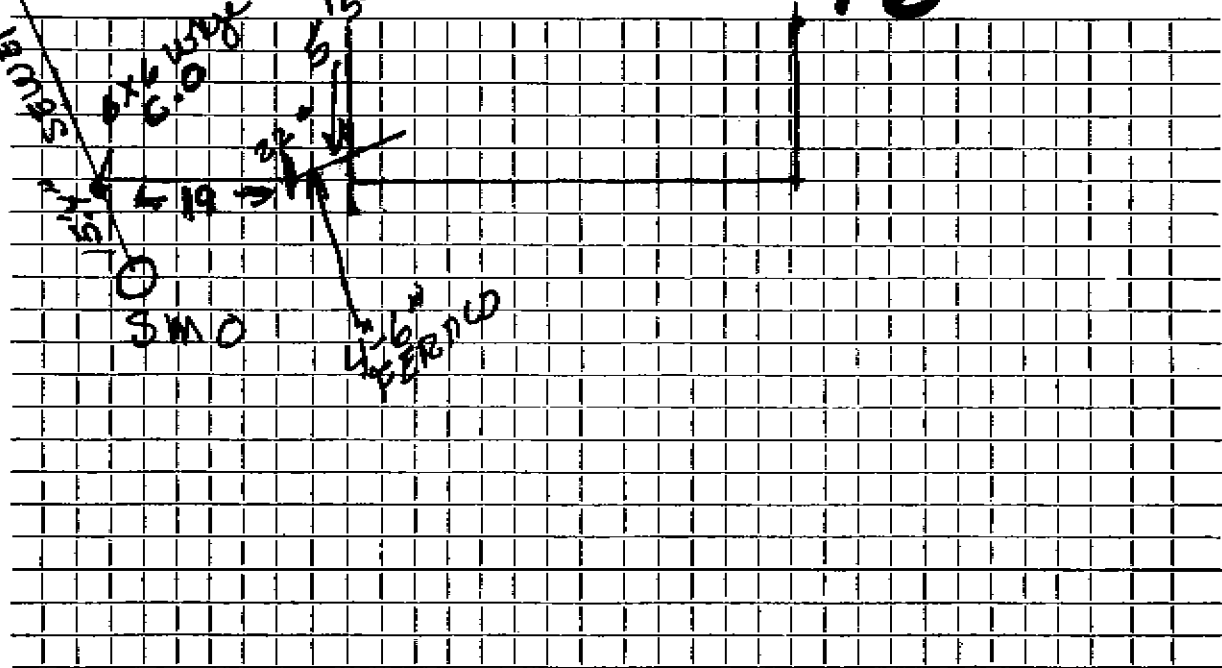

Connection made in Phillips Rd Street. Work completed

Remarks: 16