

Name Anthony C. Busa

Service No. 163

Address 18 Philips Road

18 Philip Road

Location

Kind of Pipe

Size 6"

Size of Main 8"

Repair—Renewal—New Service

Lucente #2227

Location


Date		Material	Amount	Total	Date		Amount
<del>1965</del>	<del>30'</del>	<del>Transite pipe @ 6.50</del>		195 00	10-31-72	Deposit	500 00
10/27/72	58'	Transite			5-29-73	Retard	500
	10'	4" Cast Iron			1965		125 00
					30'	6" Transite	
					1	6" X 8" Wye	

DATE \_\_\_\_\_

TOWN OF LEXINGTON — BOARD OF PUBLIC WORKS

SEWER DIVISION

Water Ties Same as Sewer Sketch of Service Here 18

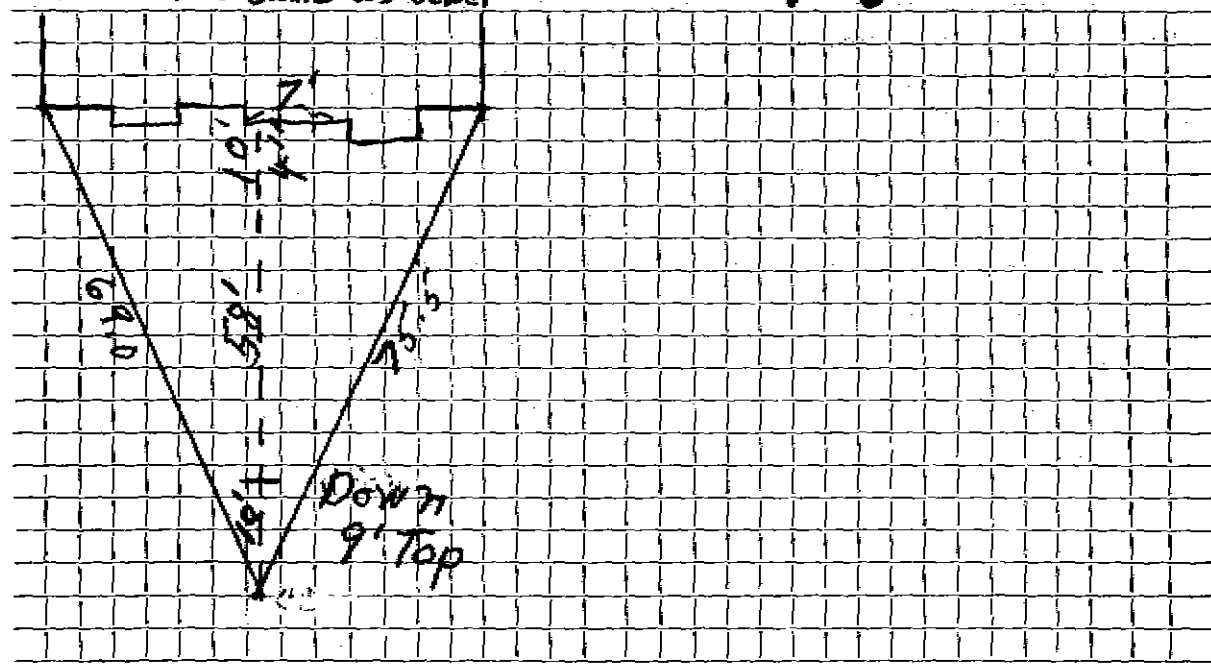

Connection made in ..... Street. Work completed .....

Remarks: .....  
.....  
.....