

Name Leonard Colwell

Service No. 150

Address 10 Phinney Road

Lot 375 Sta. 4 / 25 (7 ft. deep)

Location

Kind of Pipe

Size 6"

Size of Main 8"

~~XXXXXX~~ ~~XXXXXX~~ ~~XXXXXX~~ ~~XXXXXX~~ New Service Russell A. Sibley - Permit #89

Location DEC 28 1964

Date	Material	Amount	Total	Date	Amount
10/19/61	Labor	14 14		9-8-64	Deposit
	10% O.H.	1 41	15 55		47 93
	26' 6" Transite Pipe @ .78		20 28	10-19-61	
	1 11 1/2" Transite Bend		5 10		26' 6" Transite
	1 Hr. Trucking @ 3.00		3 00		1 6"-11 1/2" Bend
	BILL WHEN CONNECTED		43 93		1 6" X 8" Wye
-21-64	24' 6" Transite pipe				
				5-17-75	Solids
				6-24-75	Sewer Plugged
				2-27-77	Solids 42'
				3-2-77	Solids


B.M. 18501

DATE _____

TOWN OF LEXINGTON — BOARD OF PUBLIC WORKS
SEWER DIVISION

Sketch of Service Here

10

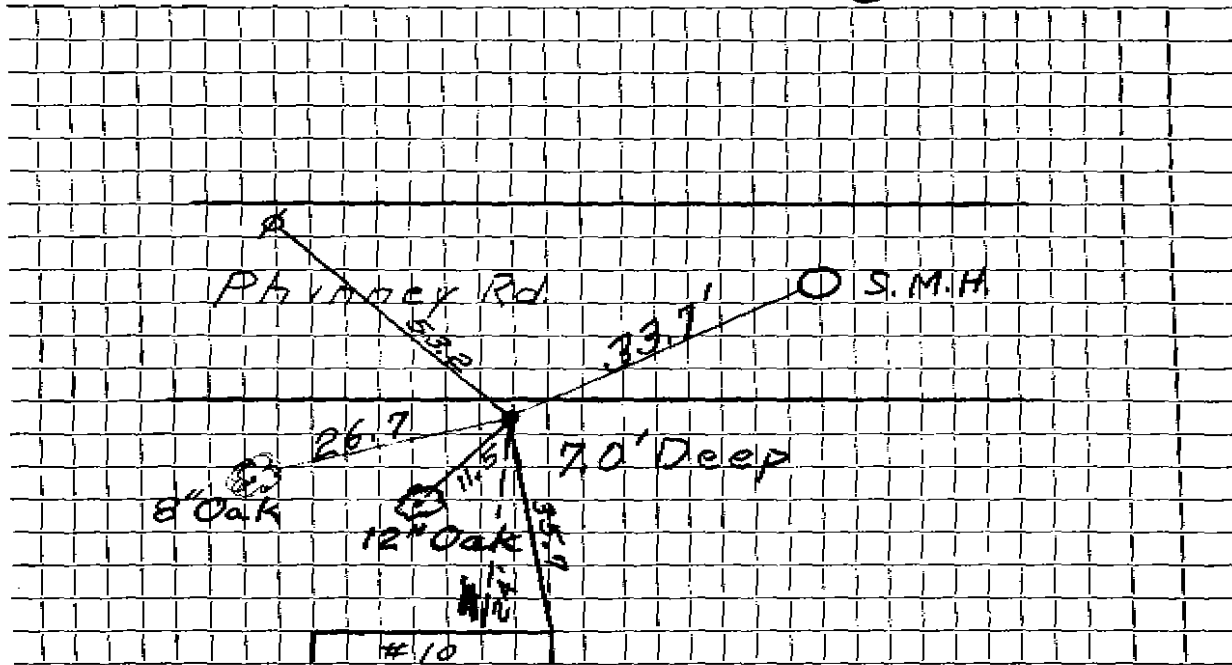

Connection made in Street. Work completed

Remarks:

.....
.....