

Name Joseph DiGiovanni

Service No. _____

Address 15 Phinney Road

15 Phinney Road

Location _____

Kind of Pipe _____

Size 6"

Size of Main 8"

Repair—Renewal—New Service Trebino #769

Location _____

| Date | | Material | Amount | | Total | | Date | | Amount | |
|----------------|------------|--------------------------|--------|--|-------|--|------|--|--------|--|
| <u>3-11-69</u> | <u>40'</u> | <u>6" Transite pipe</u> | | | | | | | | |
| | <u>10'</u> | <u>4" Cast Iron pipe</u> | | | | | | | | |
| | | | | | | | | | | |
| | | | | | | | | | | |

DATE _____

TOWN OF LEXINGTON — BOARD OF PUBLIC WORKS

SEWER DIVISION

Sketch of Service Here

15

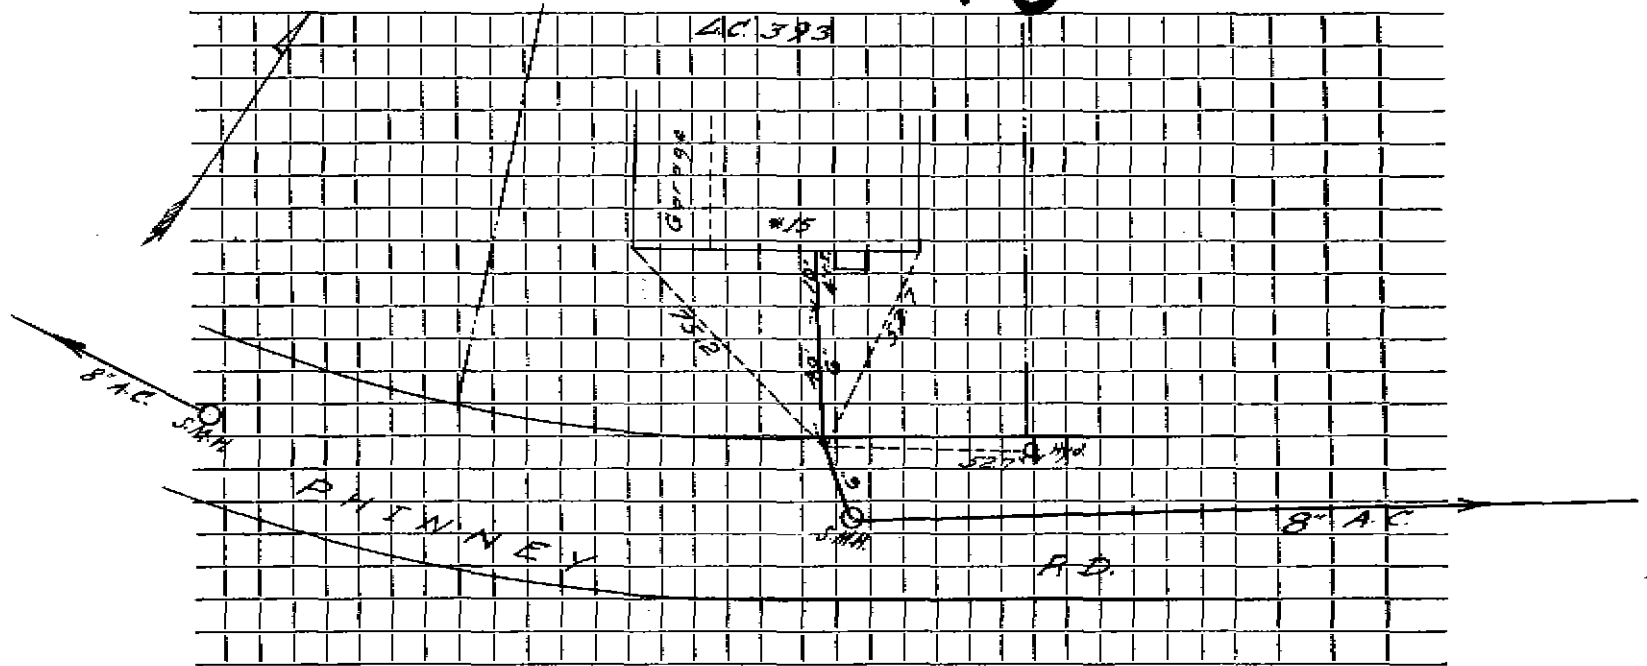

Connection made in Street. Work completed

Remarks:
.....
.....