

Name **Glenn W. Peterson**

Service No.

Address **16 Phinney Road**

16 Phinney Road

Location

Kind of Pipe

Size **6"**

Size of Main **8"**

Repair—Renewal—New Service

David Eagle permit #609

Location


Date		Material	Amount		Total	Date	Amount	
1/9/67	40'	6" Transite						
	10'	4" Cast Iron						

DATE _____

TOWN OF LEXINGTON — BOARD OF PUBLIC WORKS

SEWER DIVISION

Sketch of Service Here **16**

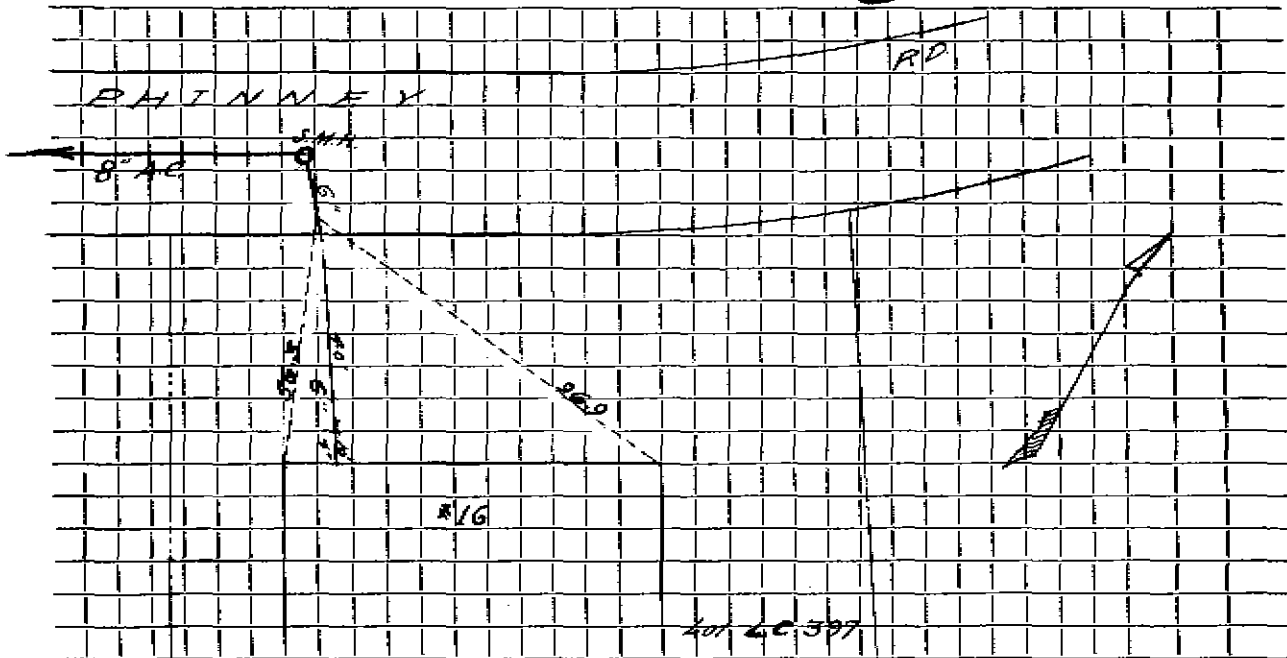

Connection made in Street. Work completed

Remarks: