

Name

Service No.

Address 20 Phinney Road

20 Phinney Road

Location

Kind of Pipe

Size 6"

Size of Main 8"

Repair—Renewal—New Service DeFelice Bros. #1170

Location


Date		Material	Amount	Total	Date	Amount
10/18/68	10'	4" Cast Iron				
	51'	6" Transite				

DATE _____

TOWN OF LEXINGTON — BOARD OF PUBLIC WORKS

SEWER DIVISION

Sketch of Service Here **20**

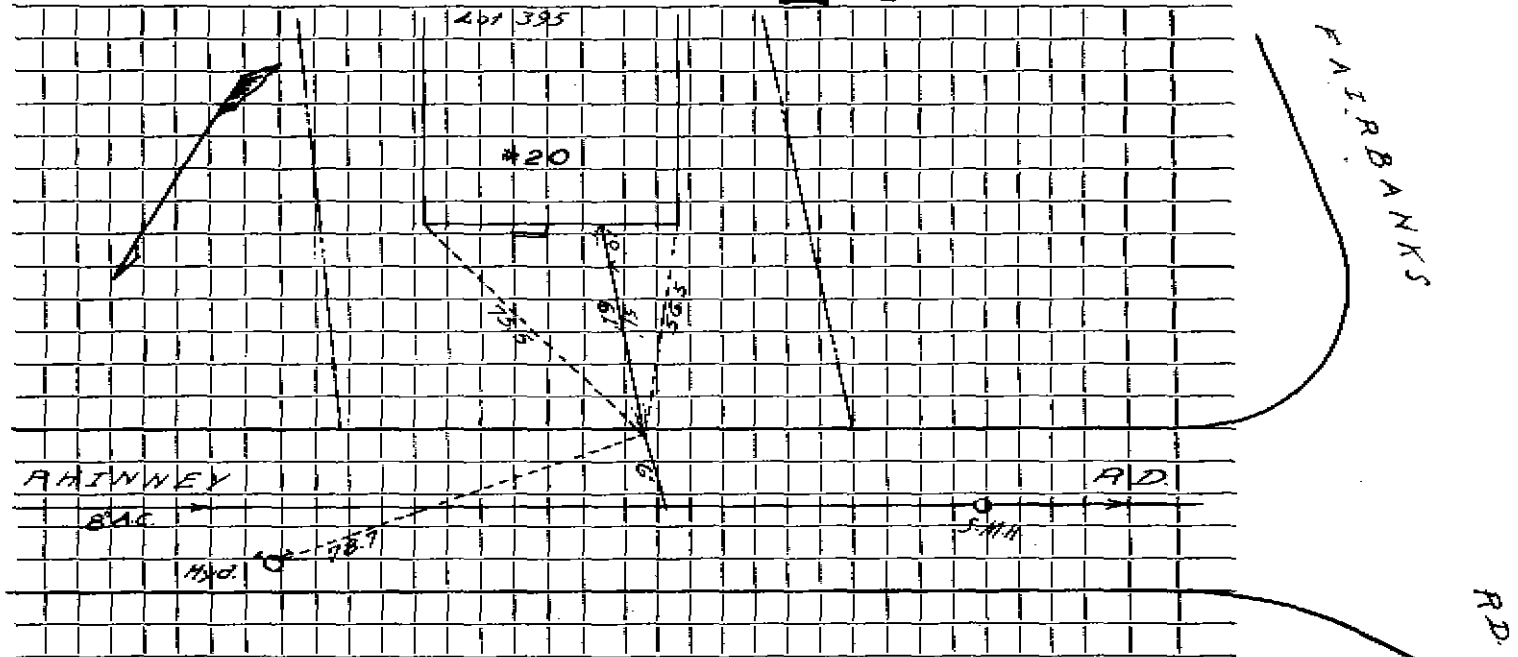

Connection made in Street. Work completed

Remarks:

.....

.....