

Name

Service No.

Address

S PHINNEY

Location

Kind of Pipe

Size

Size of Main

Repair—Renewal—New Service

Location


Date	Material	Amount	Total	Date	Amount
6.2.99	Inside renewed	house to curb		10.18.91	26-6" Transit 1- 6"x8" WYE
	491- 6" PVC				
	1- 4" x 6" DI to PVC	house			
	1- 6" x 8" PVC to AC	FRWOOD			

DATE _____

TOWN OF LEXINGTON — BOARD OF PUBLIC WORKS

SEWER DIVISION

Sketch of Service Here

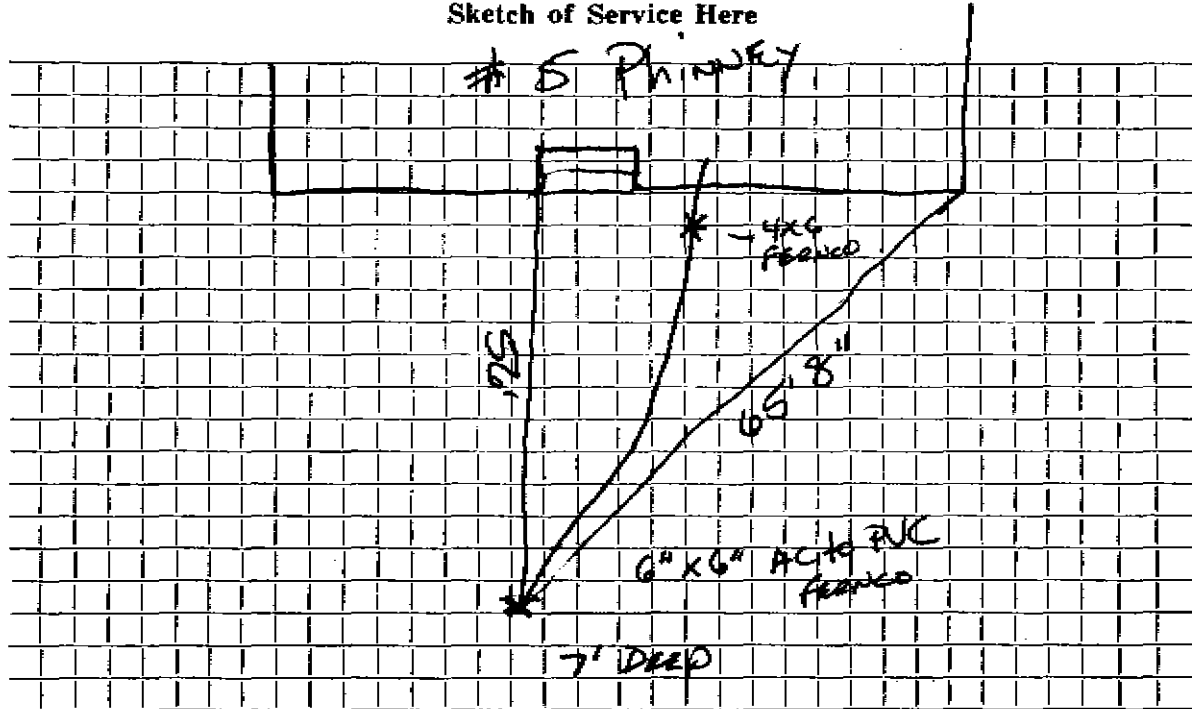

Connection made in _____ Street. Work completed _____

Remarks: Water service just to left of
facing the house