

Name Charles DiGiovanni

Service No. 161

Address 7 Phinney Road

Lot 379 Station 2 / 42 (7'3" Deep) Location

Kind of Pipe

Size 6"

Size of Main 8"

~~XXXXXXXXXX~~ New Service W/O # 8271

Location MAR 23 1964


Date	Material	Amount	Total	Date	Amount
10/18/61	Labor	14 14		10-28-63	Deposit
	10% O.H.	1 41	15 55	3-23-64	Refund
	36' 6" Transite Pipe @ .78		20 28	10-18-61	
	1 Hr. Trucking @ 3.00		3 00	26'	6" Transite
	BILL WHEN CONNECTED		38 83	1	6" X 8" Wye
1-5-63	Labor	74 05			
	10% O.H.	7 41	81 46		
	35' 6" Transite Pipe @ .82		28 70		
	1 11 1/2" Transite Bend		4 09		
	1 11 1/2" Transite Elbow		2 35		
	2 Hrs. Town Shovel @ 6.50		13 00		
	2 Hrs. Trucking @ 3.00		6 00		
			174 43		

DATE _____

TOWN OF LEXINGTON — BOARD OF PUBLIC WORKS
SEWER DIVISION

Sketch of Service Here

7

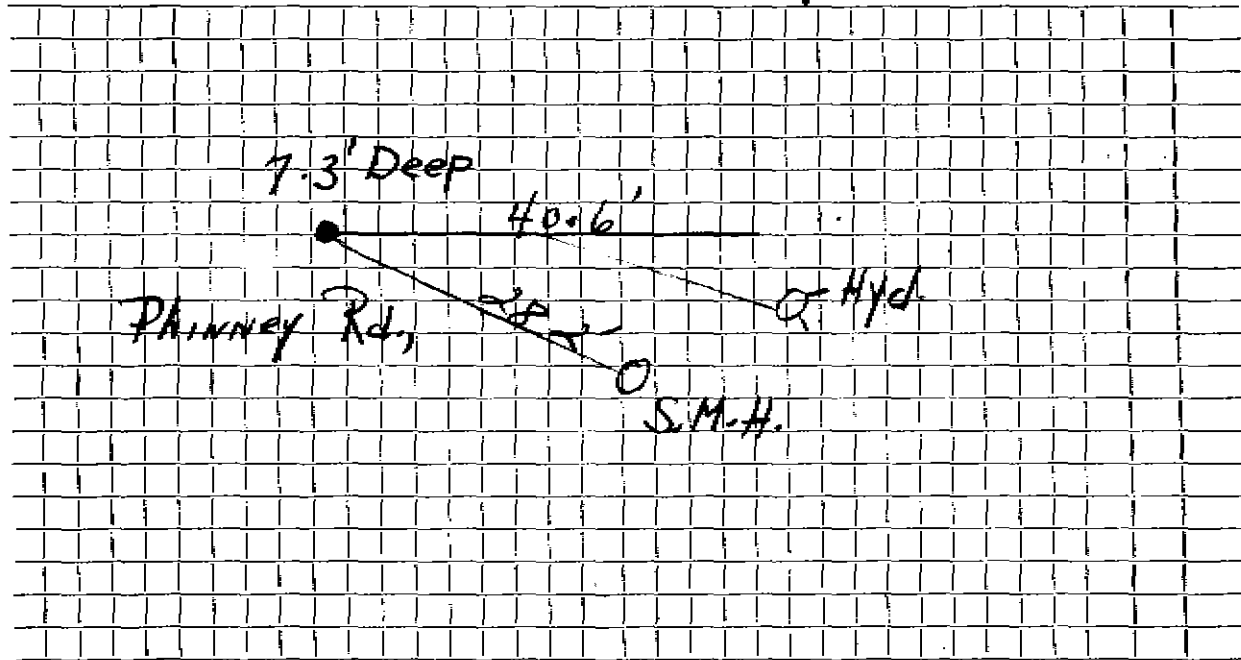

Connection made in Street. Work completed

Remarks:
.....
.....