

Name Gladys Colwell

Service No. 69

Address 8 Phinney Road

8 Phinney Road

Location

Kind of Pipe

Size 6"

Size of Main 8"

~~Repair/Replacement~~ New Service WO# 8695

Location JUN 29 1964

Date	Material	Amount	Total	Date	Amount
1/64	Labor	18 56		4-28-64	200 00
	10% O.H.	1 86	20 42	6-29-64	146 24
	37' 6" Transite Pipe @	.82	30 34		53 76
	1 Hr Trucking	3.00	3 00		
			53 76		

DATE _____


TOWN OF LEXINGTON — BOARD OF PUBLIC WORKS

SEWER DIVISION

Sketch of Service Here

8

- 49' 3/4" COP tubing inside
- 1 3/4" x 1/2" COMP VALVE
- 1 3/4" 3 part union
- 1/2" offset + ST Tail P.C
- 37' 6" SEWER PIPE
- 1 cement

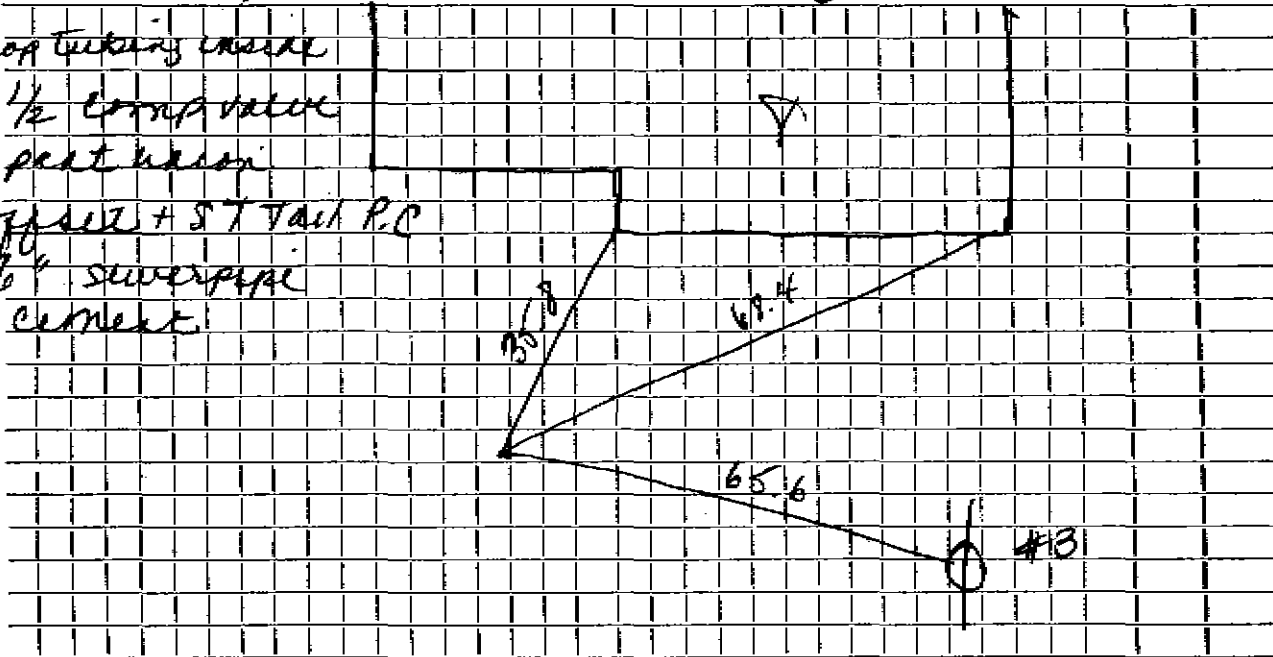

Connection made in Street. Work completed

Remarks:
.....
.....