




DATE 1-8-2001

**TOWN OF LEXINGTON — BOARD OF PUBLIC WORKS**  
**SEWER DIVISION**

Sketch of Service Here

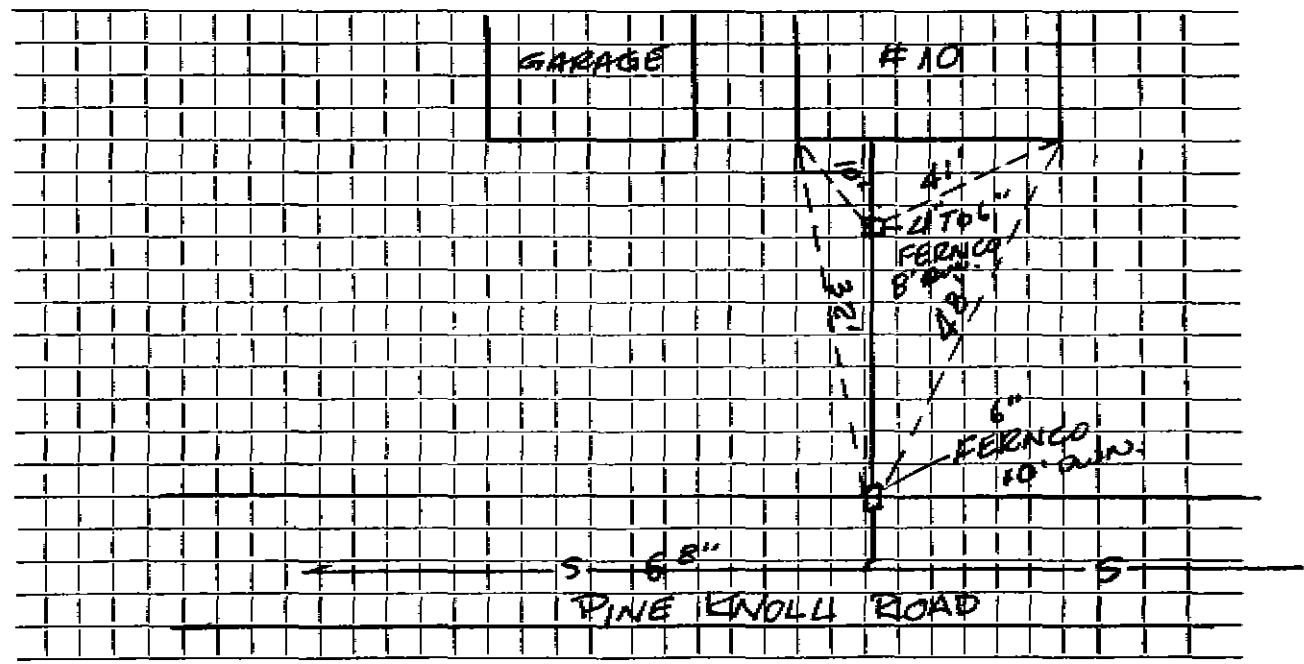

Connection made in PINE KNOOLL RD. Street.

Work completed RALPH. SURIANELLO. INC.

Remarks: .....

.....

.....