

Name David L. Bussfield

Service No. 166

Address 11 Pine Knoll Road

Lot "A" 11 Pine Knoll Rd.

Location

Kind of Pipe

Size 6"

Size of Main 8"

Repair—Renewal—New Service

Trebino #1632

Location SEP 21 1970


Date	Material	Amount	Total	Date	Amount	
1-24-70	21' 6" Transite pipe @8.00	168.00		3-17-70	Deposit	168.00
1-24-70	33' 6" Transite pipe			1970		
	10' 4" Cast Iron pipe			21' 6" Transite		

DATE _____

TOWN OF LEXINGTON — BOARD OF PUBLIC WORKS

SEWER DIVISION

Sketch of Service Here **11**

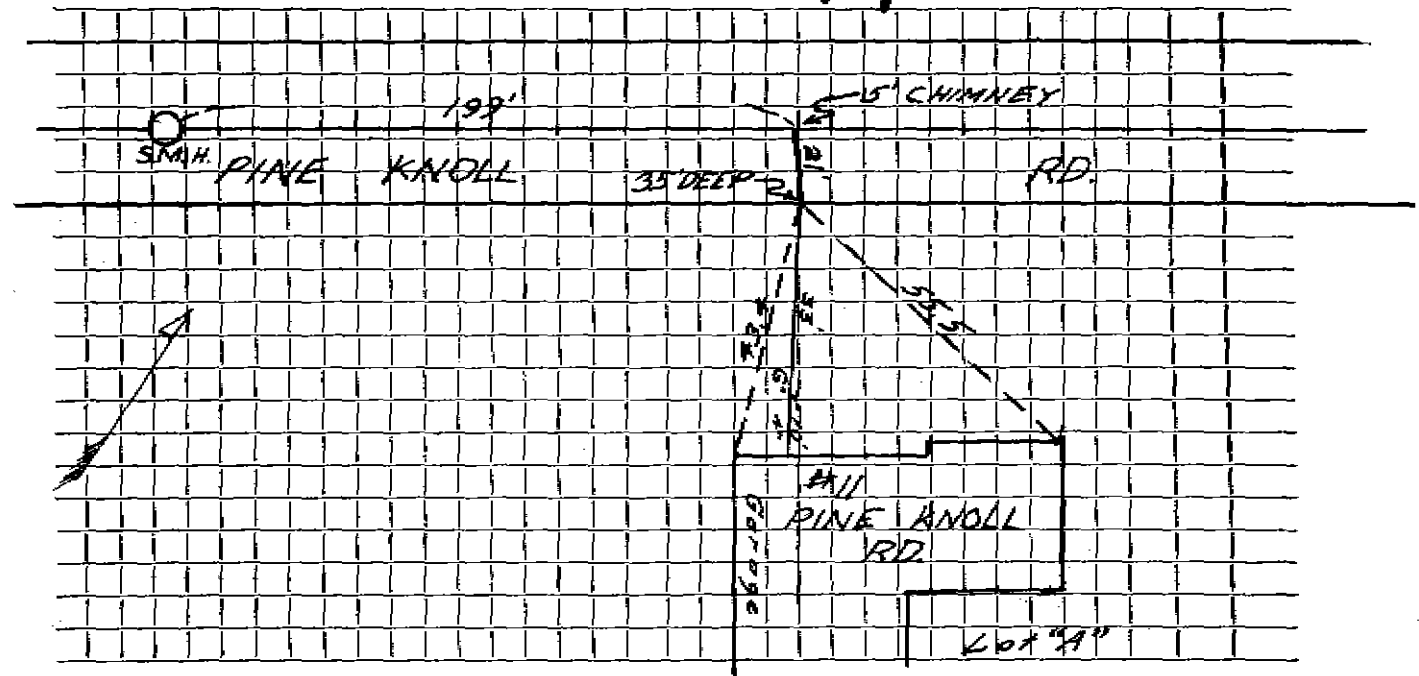

Connection made in Street. Work completed

Remarks:
.....
.....