

Name Julius Ritter

Service No. 138

Address 13 Pine Knoll Road

Lot "B" 13 Pine Knoll Rd.

Location

Kind of Pipe

Size 6"

Size of Main 8"

Repair—Renewal—New Service Trabino #1790

Location APR 21 1971

Date	Material	Amount	Total	Date	Amount
1970	15' 6" Transite pipe @ 8.00	120.00	120.00	7-16-70	120.00
12/7/70	32' 6" Transite pipe				
	10' 4" Cast Iron pipe			1970	
				15' 6" Transite	
				1 6" X 8" Wye	

L.N. 16501


DATE _____

TOWN OF LEXINGTON — BOARD OF PUBLIC WORKS

SEWER DIVISION

Sketch of Service Here

13

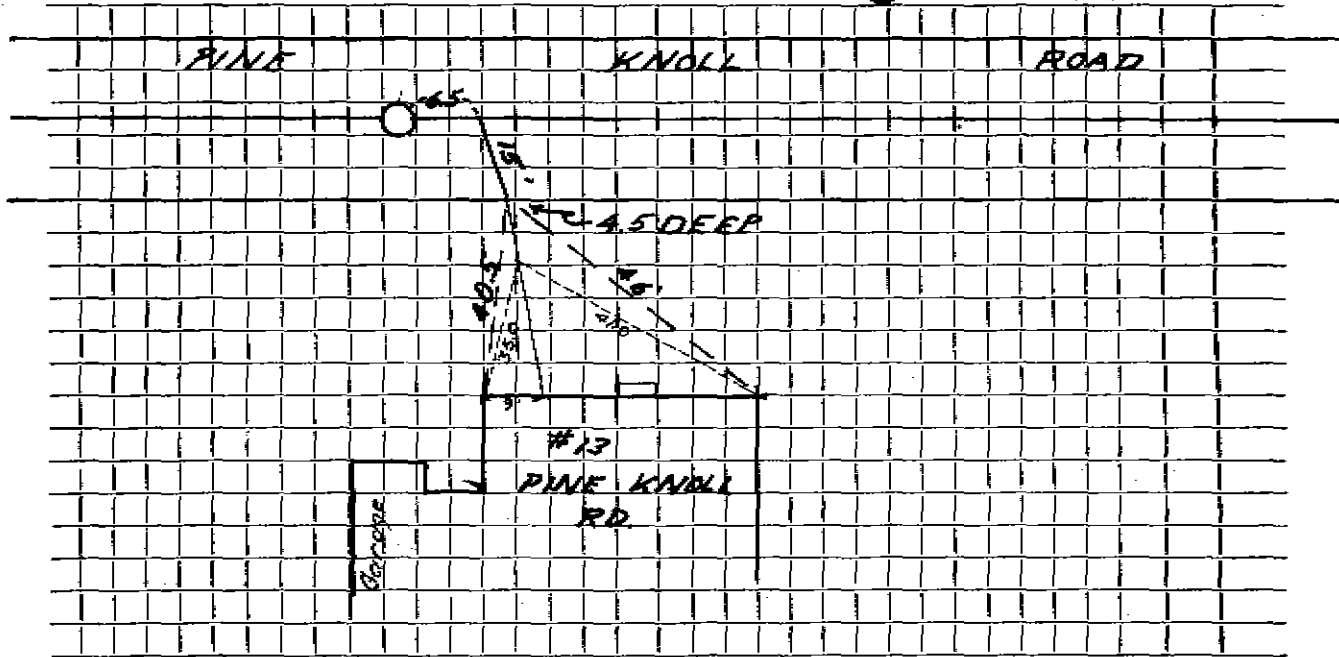

Connection made in Street. Work completed

Remarks:

.....

.....