

Name MARTIN Kiely w/ Kiely EXCAVATION

Service No.

Address 18 PINE KNOLL ROAD

Location

Kind of Pipe SDR-35

Size

6"

Size of Main


6"

Repair ~~Renewal~~ New Service

Location

Date	Material	Amount	Total	Date	Ar
1/26/21	(from ROAD to house)				
	6" → 6" FENCO	①			
	6" 22° BEND	①			
	6" SDR-35	~57'			
	6" YE - cleanout	①			
	4" - 6" FENCO	①			

Sketch of Service Here

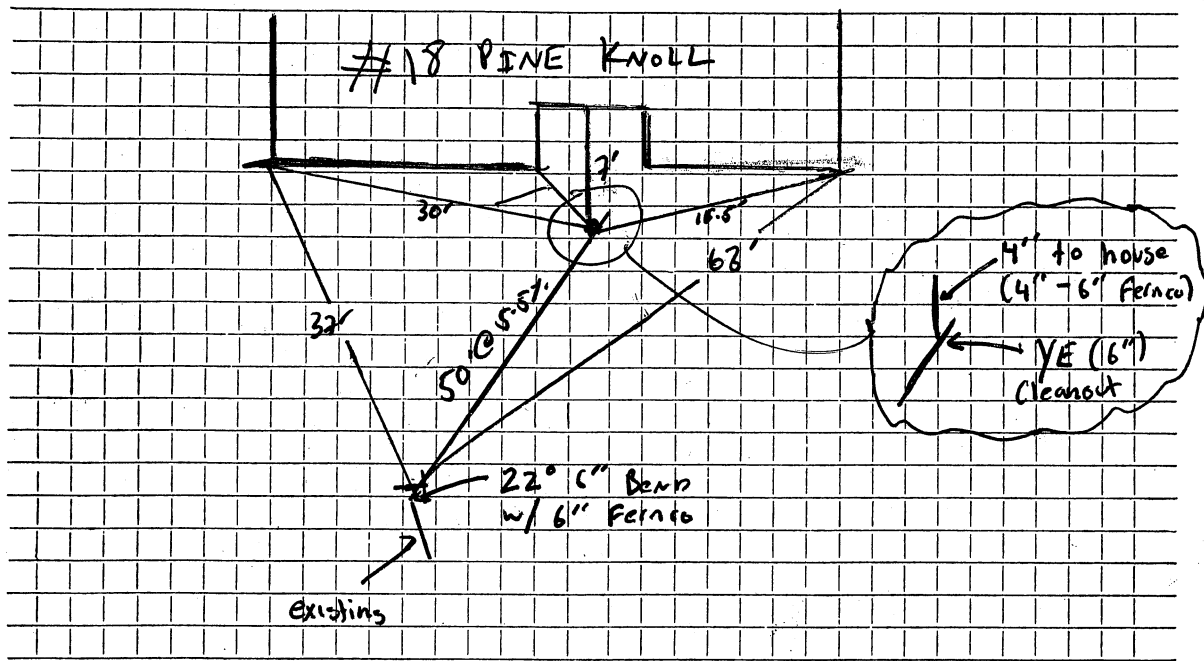

Work made in PINE KNOLL Street. Work completed

* Renewal
- ASD

Name *Gilleen Carpenter*

Service No. 36

Address *18 Pine Knoll Road*

Lot L.C. W5 18 Pine Knoll Rd. Location

Kind of Pipe *Size 6"*

Size of Main *8"*

Repair—Renewal—New Service *New Sewerage # 2837*

Location *OCT 25 1976*


Date	Material	Amount	Total	Date	Amount
1970	17' 6" 6" Transite pipe @ 8.00		136.00	<i>6-3-76</i>	<i>Deposit 136.00</i>
				<i>1970</i>	
				<i>17' 6" Transite</i>	
				<i>1 6" X 8" Wye</i>	

DATE _____

TOWN OF LEXINGTON — BOARD OF PUBLIC WORKS

SEWER DIVISION

Sketch of Service Here **18**

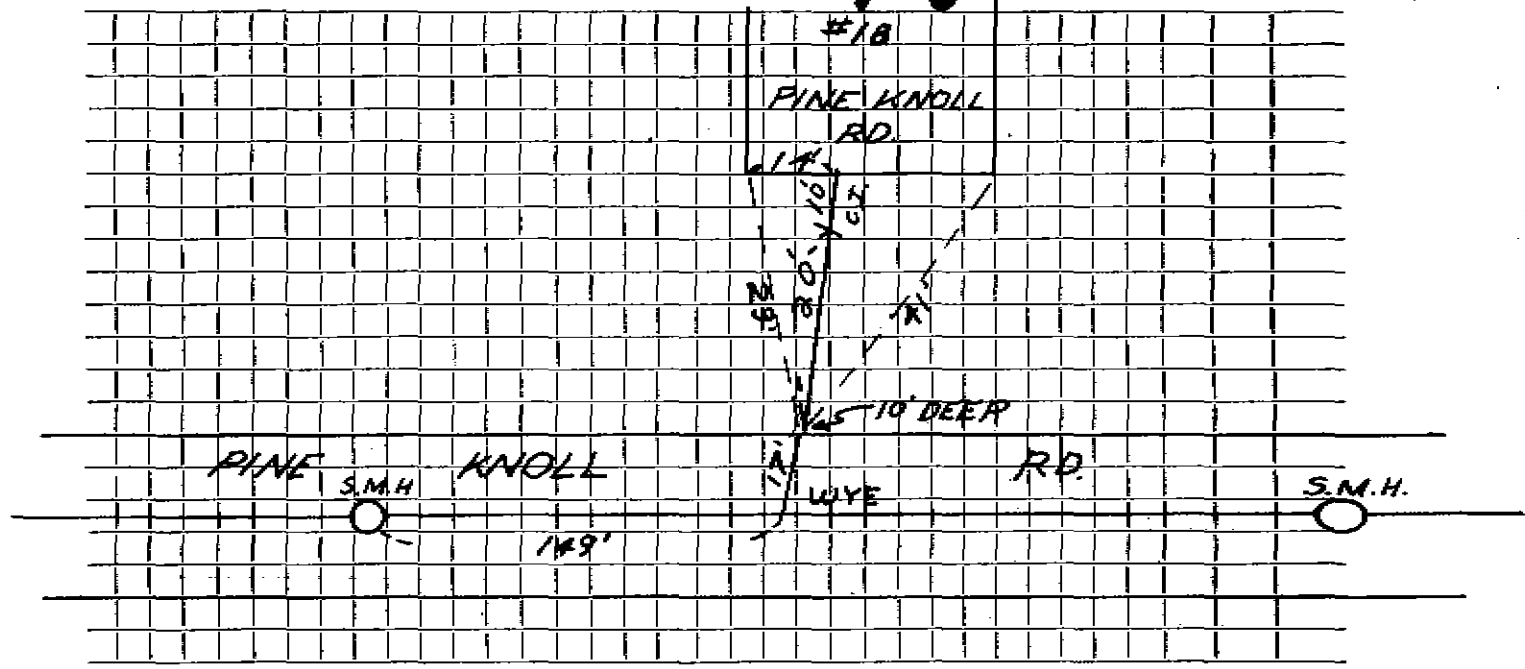

Connection made in Street. Work completed

Remarks:
.....
.....