

Name Robert J. Lord

Service No. 51

Address 22 Pine Knoll Road

Lot L.G. W6 22 Pine Knoll Rd. Location

Kind of Pipe

Size 6"

Size of Main 8"

Repair—Renewal—New Service Ferrari #1618


Location JUL 27 1970

Date	Material	Amount	Total	Date	Amount
1970	17' 6" Transite pipe @8.00		136.00	6-29-70	136.00
7-2-70	30' 6" Transite pipe				
				1970	
				17' 6" Transite	
				1 6" X 8" Wye	

TOWN OF LEXINGTON — BOARD OF PUBLIC WORKS

SEWER DIVISION

Sketch of Service Here **22**

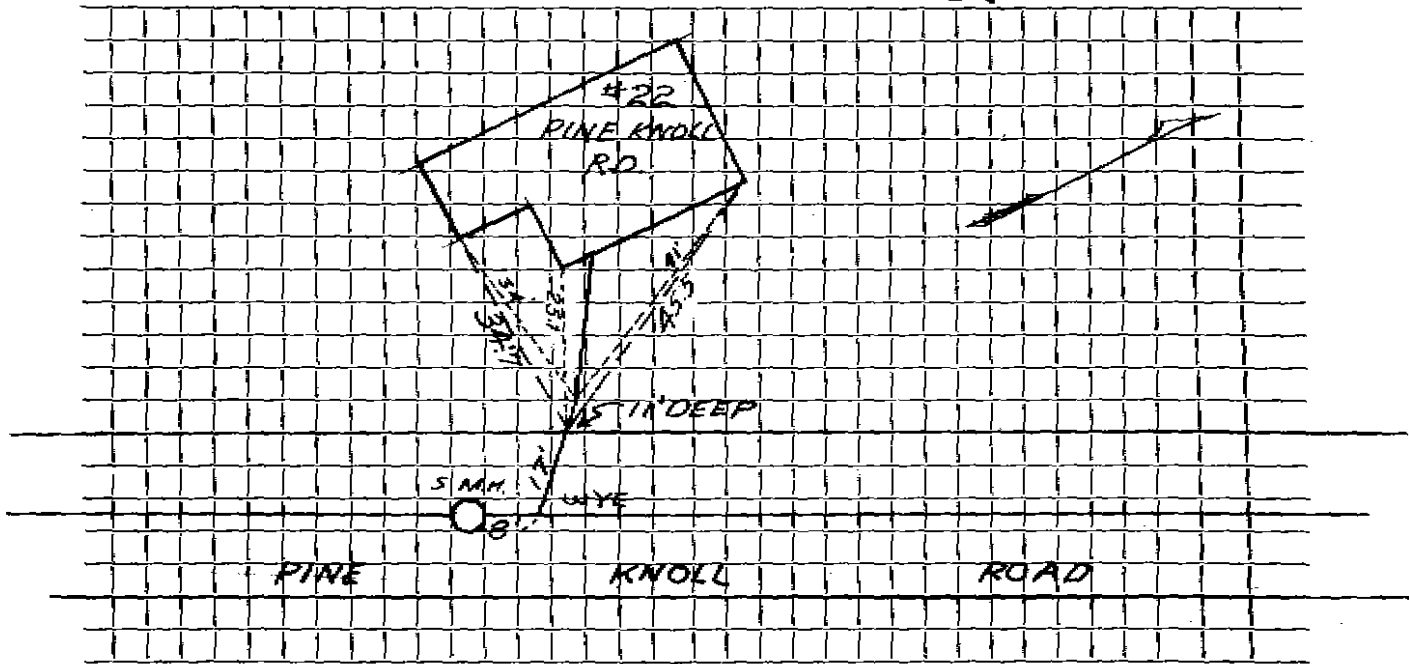

Connection made in Street. Work completed

Remarks:
.....
.....