


DATE 1970

TOWN OF LEXINGTON — BOARD OF PUBLIC WORKS

SEWER DIVISION

Sketch of Service Here 3

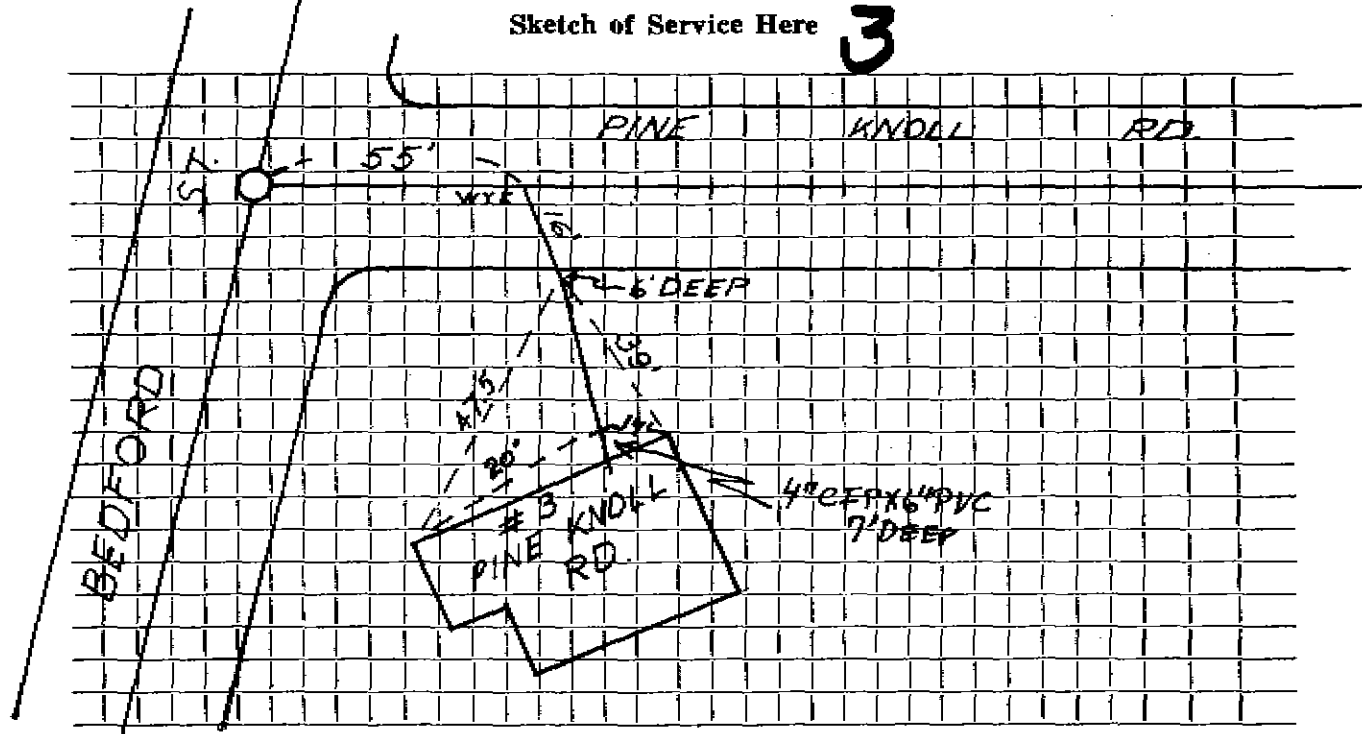

Connection made in PINE KNOLL AVE. Street. Work completed 10-29-82

Remarks: