


DATE _____

TOWN OF LEXINGTON — BOARD OF PUBLIC WORKS

SEWER DIVISION

Sketch of Service Here **31**

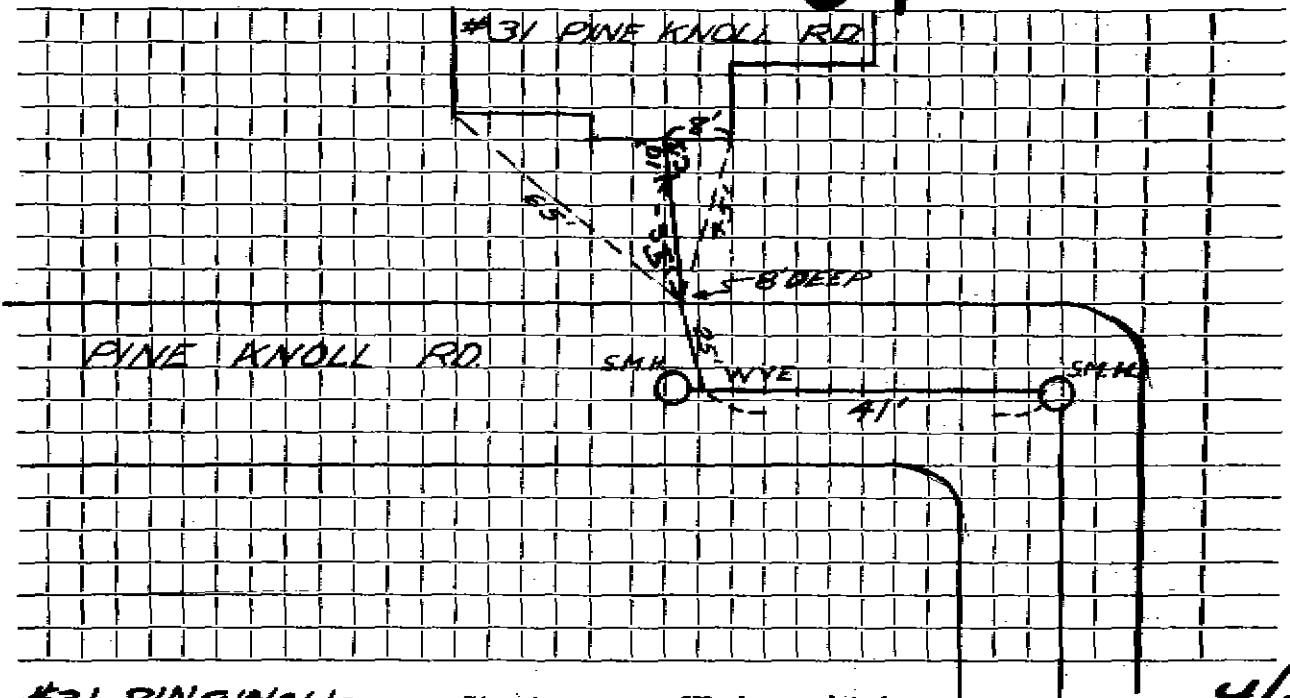

Connection made in #31. PINE KNOLL Street.

Work completed 4/27/76

Remarks: