


TOWN OF LEXINGTON — BOARD OF PUBLIC WORKS
DATE _____

SEWER DIVISION

Sketch of Service Here

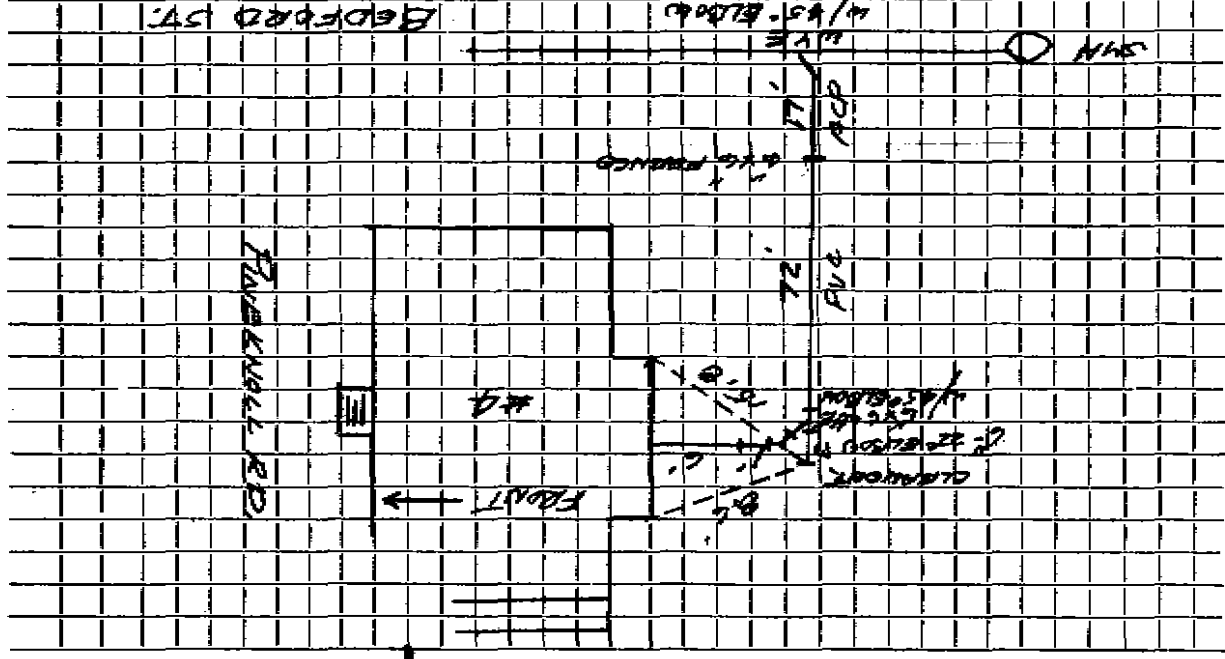

4

Work completed _____

Street _____

Connection made in **BEDFORD**

Remarks: _____