

Name David Davis

Service No.

Address " G Pine Knoll Rd.

lift l.c. #8 Pine Knoll Rd. location

Kind of Pipe PVC Size 4" x 4"

Repair—Renewal ~~Close Service~~

Location

Date	Material	Amount	Total	Date	Amount
5/8/93	4.5 LF 4" PVC			5/13/93	bid
	34.5 LF 6" PVC				152.00
	6" x 6" x 42 E.O.				
	4" x 4.5" x 60 w				
	4" x 6" x 60 w				
	2 - 6" x 6" x 60 w				
	6" x 6" x 60 w				
	App 191 6" Transite pipe				152.00


DATE \_\_\_\_\_

TOWN OF LEXINGTON — BOARD OF PUBLIC WORKS

SEWER DIVISION

Sketch of Service Here

8

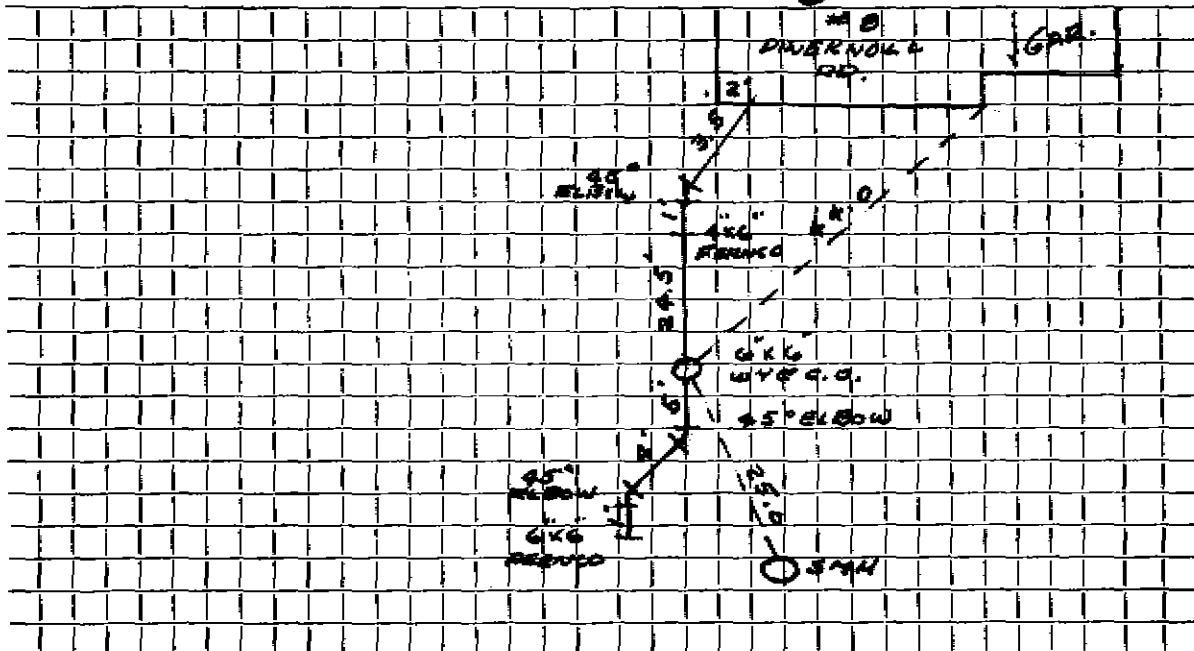

Connection made in PINEKNOLL RD. Street. Work completed .....

Remarks: .....

.....