

Name

Service No.

Address 9 Pine Knoll Road

Lot 10 "X" 2 9 Pine Knoll Road Location

Kind of Pipe

Size 6"

Size of Main 8"

Repair—Renewal—New Service

Location

| Date | Material | Amount | Total | Date | Amount |
|----------------|---|--------|--------|----------------|--------|
| 970 | 21' 6" Transit pipe @ \$3.00 | | 168.00 | 1970 | |
| | | | | 21' 6" Transit | |
| | | | | | |
| | | | | | |



DATE _____

TOWN OF LEXINGTON — BOARD OF PUBLIC WORKS
SEWER DIVISION

Sketch of Service Here

9

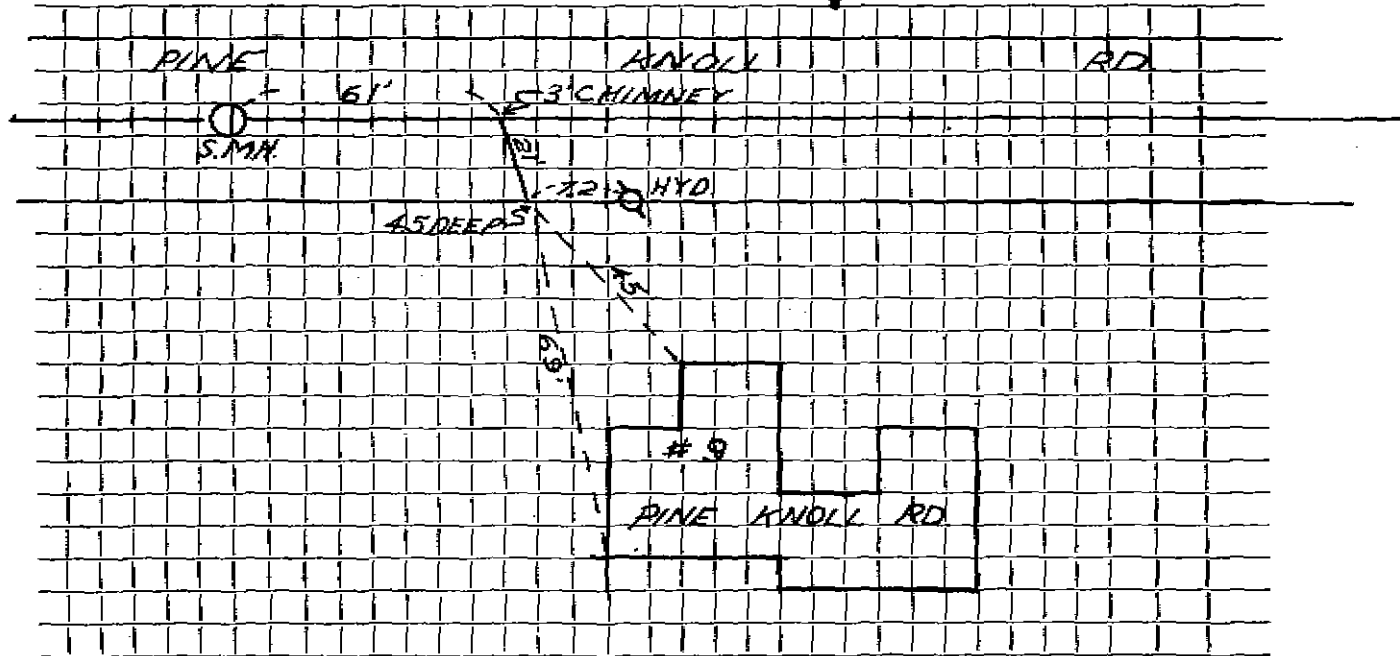

Connection made in Street. Work completed

Remarks:

.....
.....