

Service No. 111

Address 18 Pinewood St.

18 Pine wood Street

Location Same

Kind of Pipe

Size 6"

Size of Main 8"

~~Repaired~~ New Service

Location

Date	Material	Amount	Total	Date	Amount
April 18 <i>Comm. to Repair Worked</i>	17 hrs. Labor @ 55¢	9 35			
	6 " " 60¢	3 60	12 95		
	10% Overhead on labor		1 30	April 6, 1935 - Deposited	30 00
	46' 6" Sewer Pipe @ 20¢		9 20	June 19, 1935 - Refunded	5 05
	Sulphur & Jute		75		24 95
	Trucking		75		
			\$24 95		
	Labor				

TOWN OF LEXINGTON—BOARD OF PUBLIC WORKS
SEWER DIVISION

DATE April 8, 1935

NO. _____


The undersigned applies for the construction of a particular sewer connecting No. _____
Street and hereby agrees to comply with the Rules and Regulations governing the construction and use of Particular
Sewers, as now or at any future time established by the Board of Selectmen.

Am't. of Estimate \$ 30.00

Am't. Paid \$ _____

Jenot L. Smith Owner
by H. Williams

Sketch of Service Here

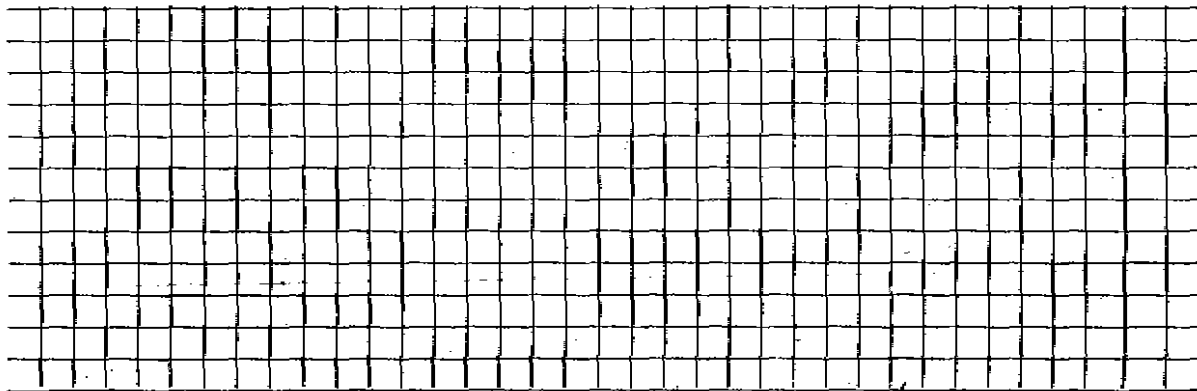

Connection made in 18 Pinewood Street.

Work completed _____ 19

Remarks: