

Name

Service No.

Address # 2 Pinewood St.

2 Pinewood Street

Location

Kind of Pipe AC

Size 6"

Size of Main 8"

Repair—Renewal—New Service Valeri # 2493


Location

Date	Material	Amount	Total	Date	Location	Amount
6-11-74	10' 4" CI			6-5-74	Deposit	350 00
	40' 6" AC			2-10-75	Refund	193 54
				6-10-74		156 46
				20'	6" Transite	
				1	6" X 8" Wye	

DATE _____

TOWN OF LEXINGTON — BOARD OF PUBLIC WORKS
SEWER DIVISION

Sketch of Service Here **2**

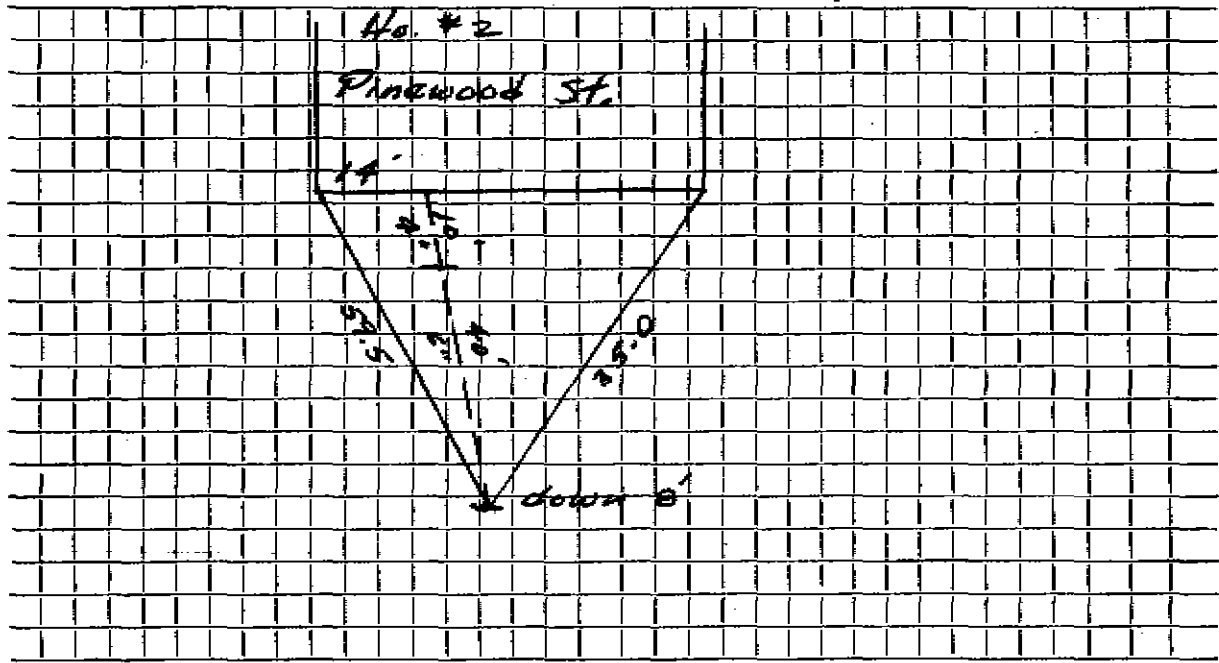


Connection made in Street. Work completed

Remarks:
.....
.....

DATE OCT 15 1998

TOWN OF LEXINGTON — BOARD OF PUBLIC WORKS
SEWER DIVISION

Sketch of Service Here

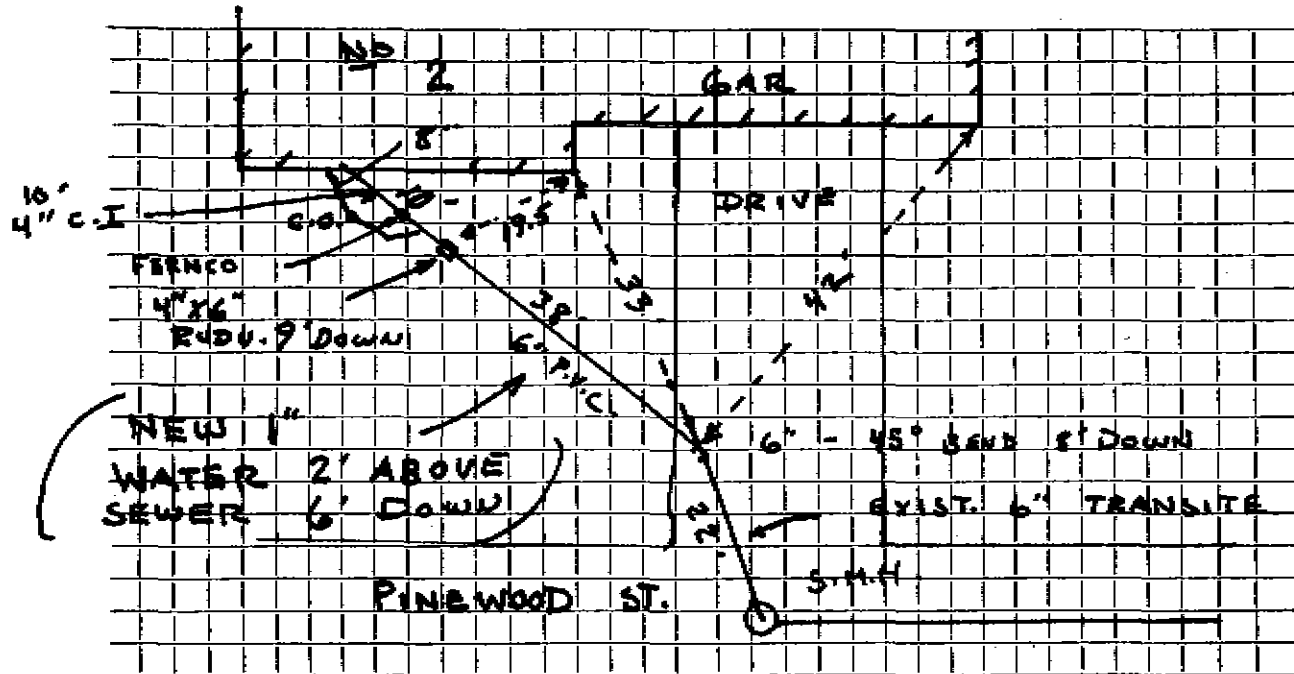

Connection made in PINE WOOD Street. Work completed P.H.D. CONNECTION, INC.
Remarks: NEW WATER LINE 2' ABOVE SEWER 6' DOWN (NEW WATER LINE RUNS TO CURB STOP TO THE 4" X 6" REDUCER)
SEE FIELD BOOK 98-2 TAM