




DATE 9/23/92

TOWN OF LEXINGTON — BOARD OF PUBLIC WORKS

SEWER DIVISION

Sketch of Service Here **3**

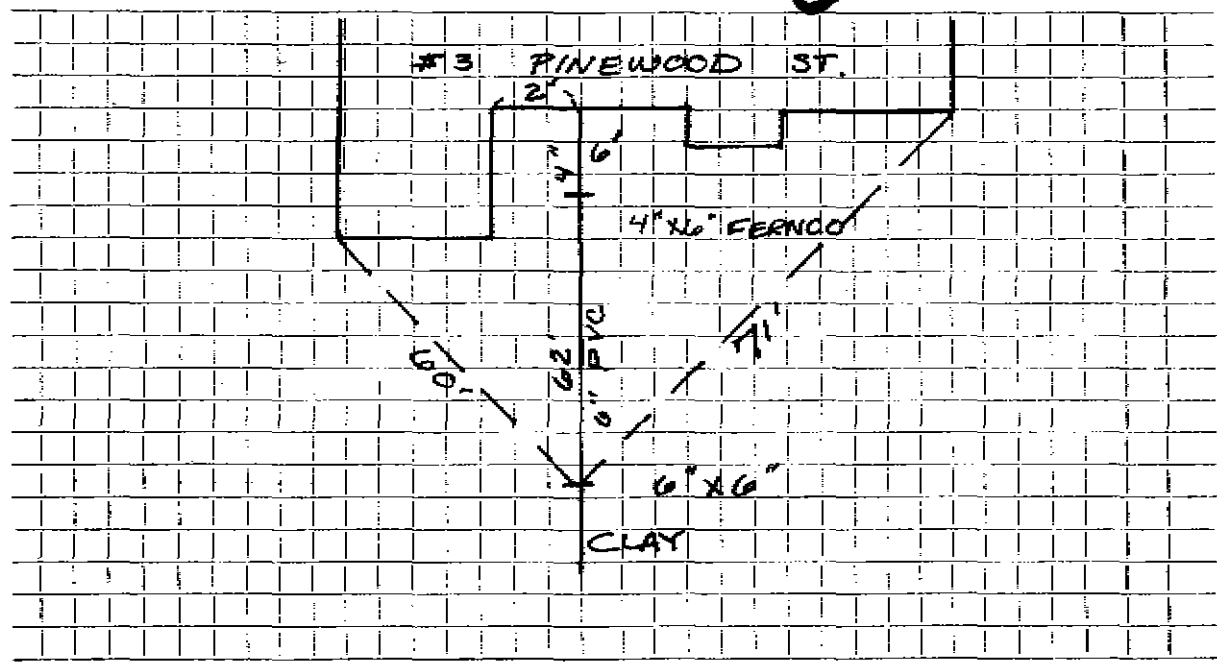

Connection made in PINEWOOD Street. Work completed BANKS  
Remarks: Original Service 7-24-54 (60'-6\" Sewer Pipe)