




DATE SEPT 2001

TOWN OF LEXINGTON — BOARD OF PUBLIC WORKS  
SEWER DIVISION

Sketch of Service Here

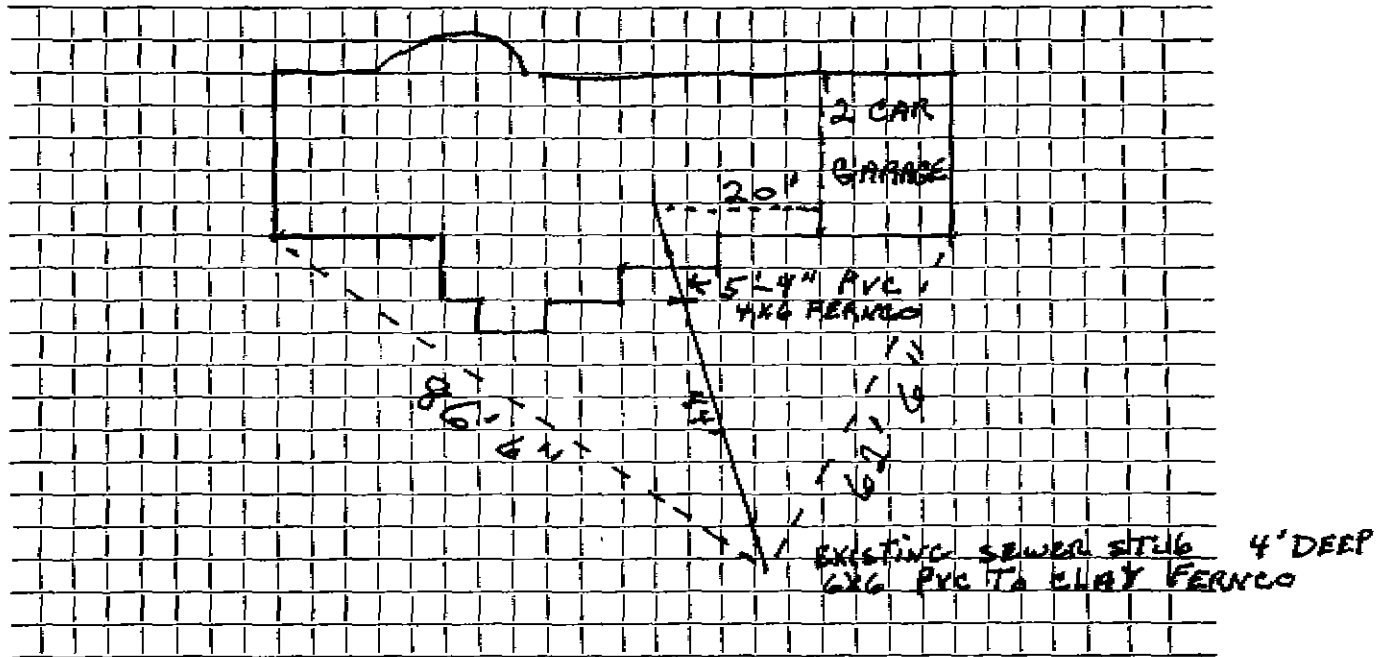

Connection made in PINEWOOD Street. Work completed SEPT 2001

Remarks: INSTALLED BY J. M. McLAUGHLIN