

Name 5 PITCAIRN PLACE

Service No.

Address

5 Pitcairn Place

Location

Kind of Pipe PVC

Size 6"

Size of Main 8"

Repair—Renewal—New Service

Location


Date	Material	Amount	Total	Date	Amount
<u>4/11</u>	<u>83 58 LF 6" PVC</u>	<u>16 00</u>	<u>928 00</u>		

DATE 4-15-83

TOWN OF LEXINGTON — BOARD OF PUBLIC WORKS  
SEWER DIVISION

Sketch of Service Here

5

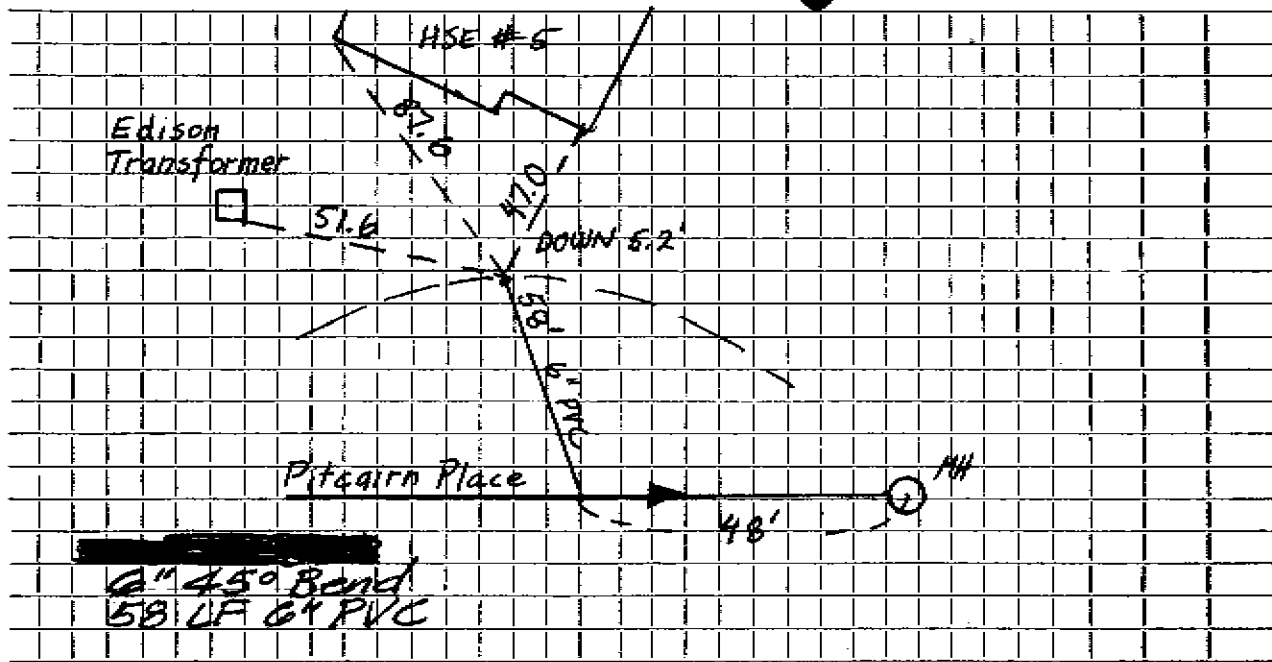

Connection made in PITCAIRN PLACE Street. Work completed .....

Remarks: .....