

Name James Buckley

Service No. 29

Address 6 PITCAIRN PLACE

6 Pitcairn Place

Location

Kind of Pipe PVC

Size 6"

Size of Main 8"

~~Repair Renewal~~ New Service Arlex #3855

Location FEB 27 1984


Date	Material	Amount	Total	Date	Amount
1/12 83	50 LF 6" PVC	16 00	800.00	8-19-83	Deposit 800.00
2/83 63'	6" P.V.C.				
5'	4" Cast				
1	6" Wye				
1	6" 45° Bend				
1	6" 22° Bend				
	4" x 6" Donut				

DATE 7-14-83

TOWN OF LEXINGTON — BOARD OF PUBLIC WORKS  
SEWER DIVISION

Sketch of Service Here

6

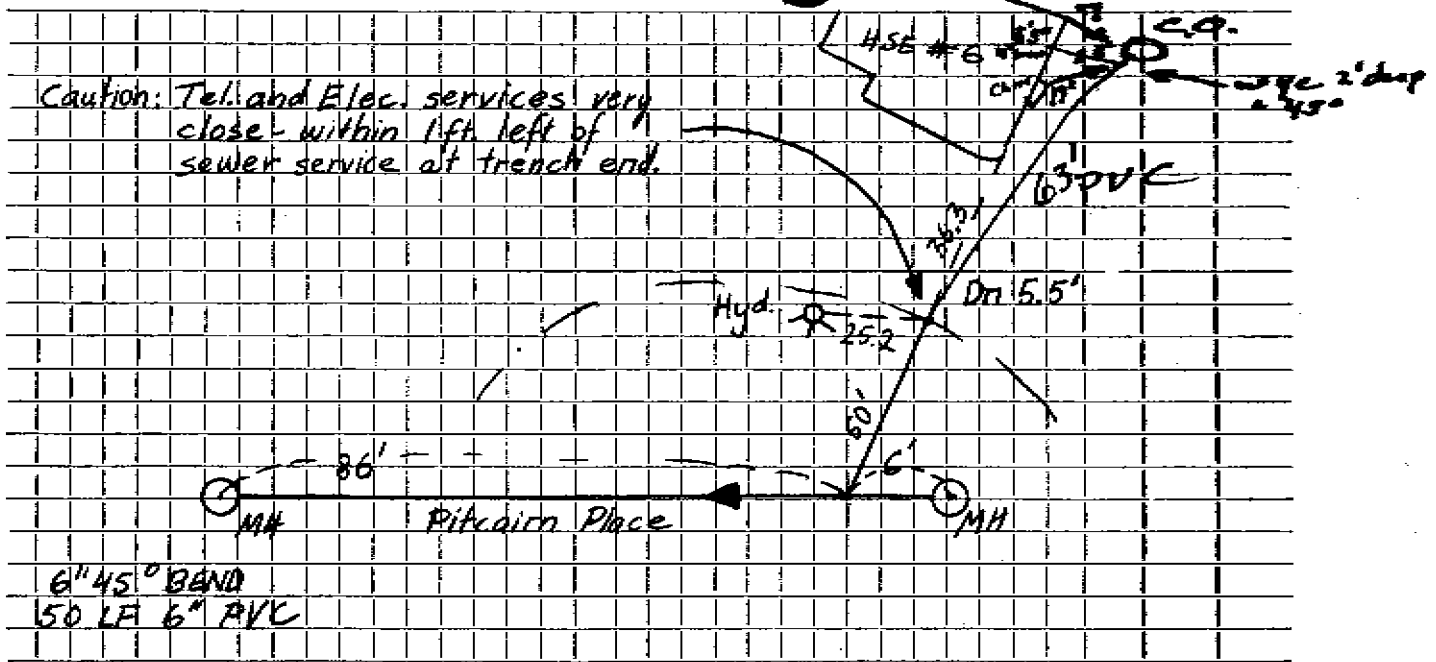

Connection made in PITCAIRN PLACE Street. Work completed .....

Remarks: .....