

Name **Richard R. Eurich**

Service No. **31**

Address **7 PITCAIRN PLACE**

7 PITCAIRN PLACE

Location

Kind of Pipe **PVC**

Size **6"**

Size of Main **8"**

~~Respatch/Dismantle~~New Service Valeri #4594

Location


Date	Material	Amount	Total	Date	Amount
1/13	38 LF 6" PVC	16 00	608.00	9-15-86	608.00
7/86	6" PVC				
	4" CI				
	1 Donut				

DATE 7-14-83

TOWN OF LEXINGTON — BOARD OF PUBLIC WORKS

SEWER DIVISION

Sketch of Service Here **7**

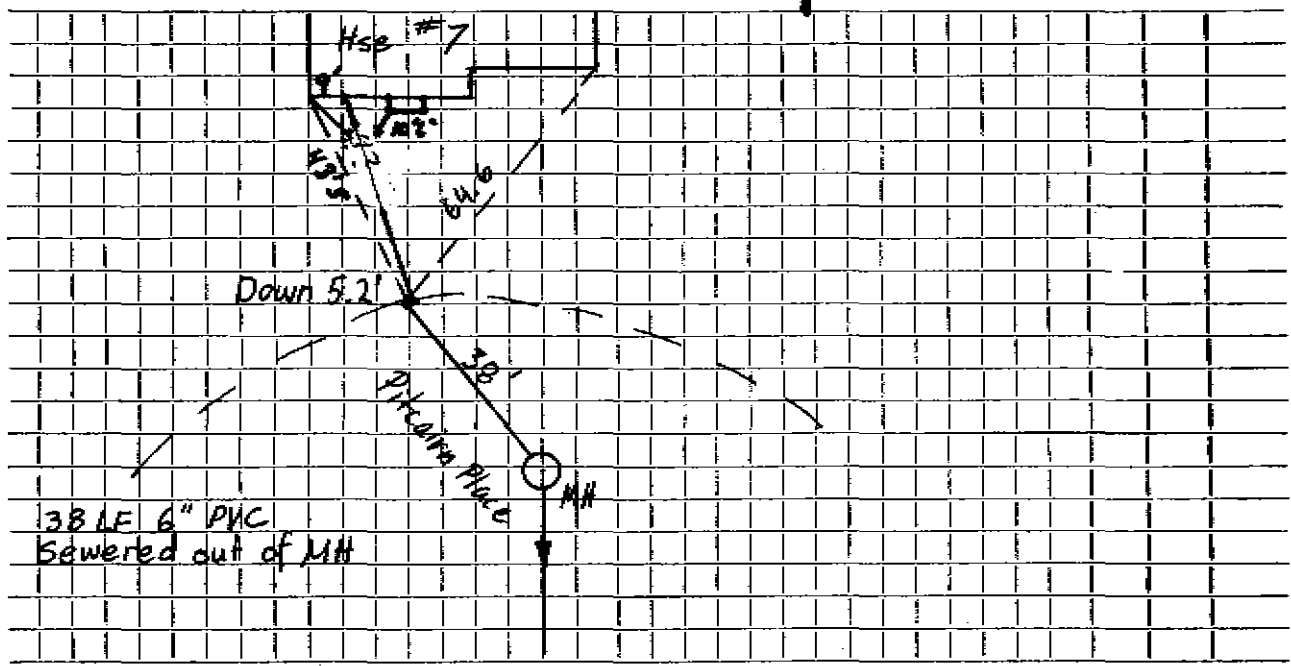

Connection made in PITCAIRN PLACE Street. Work completed

Remarks:
.....
.....