


DATE _____

TOWN OF LEXINGTON — BOARD OF PUBLIC WORKS
SEWER DIVISION

Sketch of Service Here

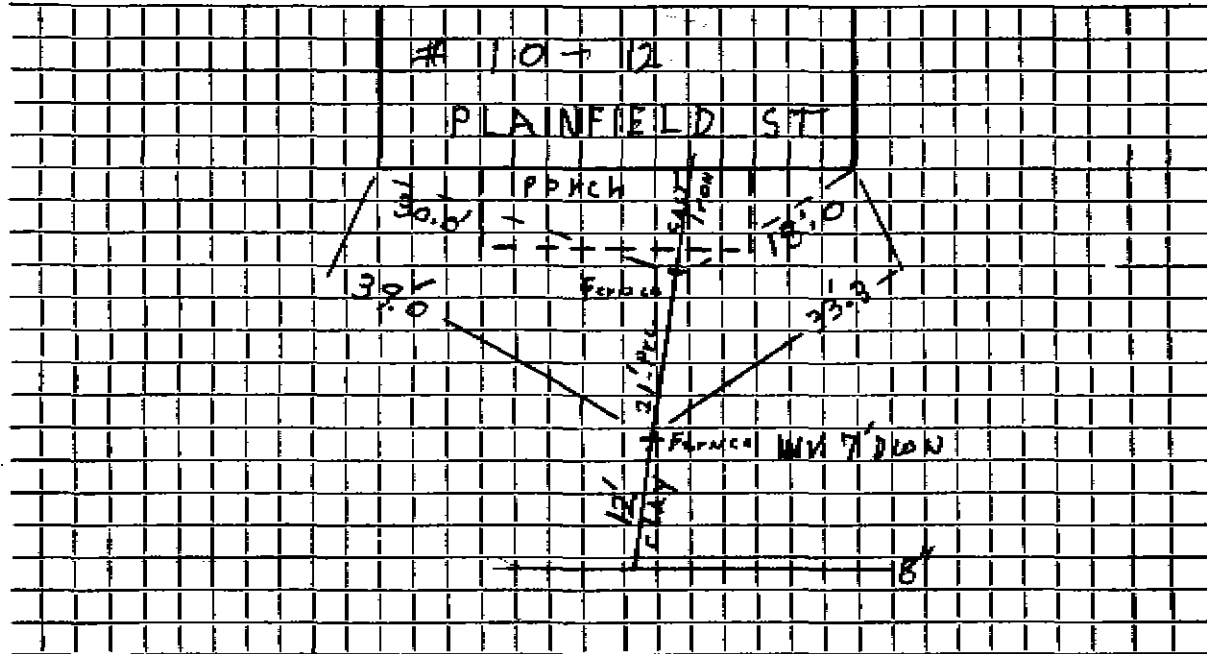

Connection made in Street. Work completed 4/25/06 J. McLaughlin

Remarks: 1928-33' of 6" Clay Pipe / Tied on 4" Cast Iron in front of Porch