

Gladya Colwell

Service No. 5 120

Address 15 Bartlett Avenue, Lexington

*11 Plainfield St Location Lot 6A Plainfield Street

Kind of Pipe

Size 6"

Size of Main 8"

Repair—Renewal—New Service

Location

Date 1939	Material	Amount	Total	Date	Amount
April 12,	24 hrs. @ 55¢	13 20		April 2, 1939	50 00
Jan 21 39	24 " @ 60¢	14 40	27 60	Deposited	
	10% Overhead		2 76		
	38' 6" Sewer Pipe @ 20¢		7 60		
	1 6" 1/8 Bend		65		
	1 6 x 4 Reducer		1 00		
	Jointing Compound		2 28		
	Compressor, 2 hrs. @ 3.00		6 00		
	Trucking, 2 hrs. @ 75¢		1 50		
	Trench Repairs		8 00		
			57 39		
	Charge: Flate Rate:	\$50.00			
	Labor				

H. O. G. & P. Co., Inc., Lexington

TOWN OF LEXINGTON - BOARD OF PUBLIC WORKS

SEWER DIVISION

DATE

Feb 24 1934

NO.

Lot # 6 A Plainfield St.

The undersigned applies for the construction of a particular sewer connecting No. *Lot # 6 A Plainfield St.* Street and hereby agrees to comply with the Rules and Regulations governing the construction and use of Particular Sewers, as now or at any future time established by the Board of Selectmen.


Am't. of Estimate \$ _____

Am't. Paid \$ _____

Gladys M. Colwell Owner

see water application for estimates

Sketch of Service Here

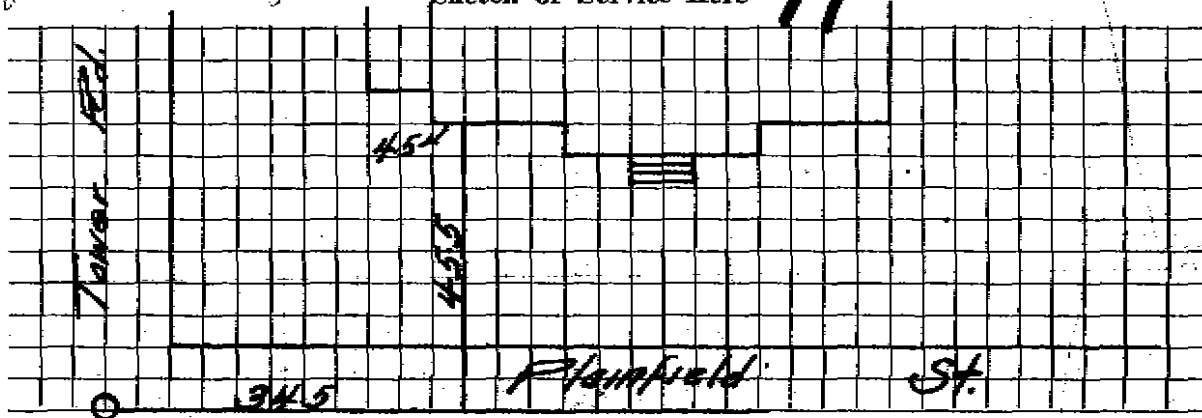

Connection made in _____ Street.

Work completed _____ 19

Remarks: