

Name

Service No.

Address 8 Plainfield ST

Location

Kind of Pipe PVC

Size 6"

Size of Main 8"

Repair-Renewal-New Service

JASON ANTHONY CORP


Location

Date	Material	Amount	Total	Date	Amount
ORIGINAL SERVICE	11/8/1927				
7/17/2004	10' 4" S-L 40 PVC				
	40' 6" PVC				
	1 4X6 FENCE				
	1 90° ON CORNER EXISTING				
IN SP.	DAVE CARBUROW				

DATE \_\_\_\_\_

TOWN OF LEXINGTON — BOARD OF PUBLIC WORKS  
SEWER DIVISION

Sketch of Service Here

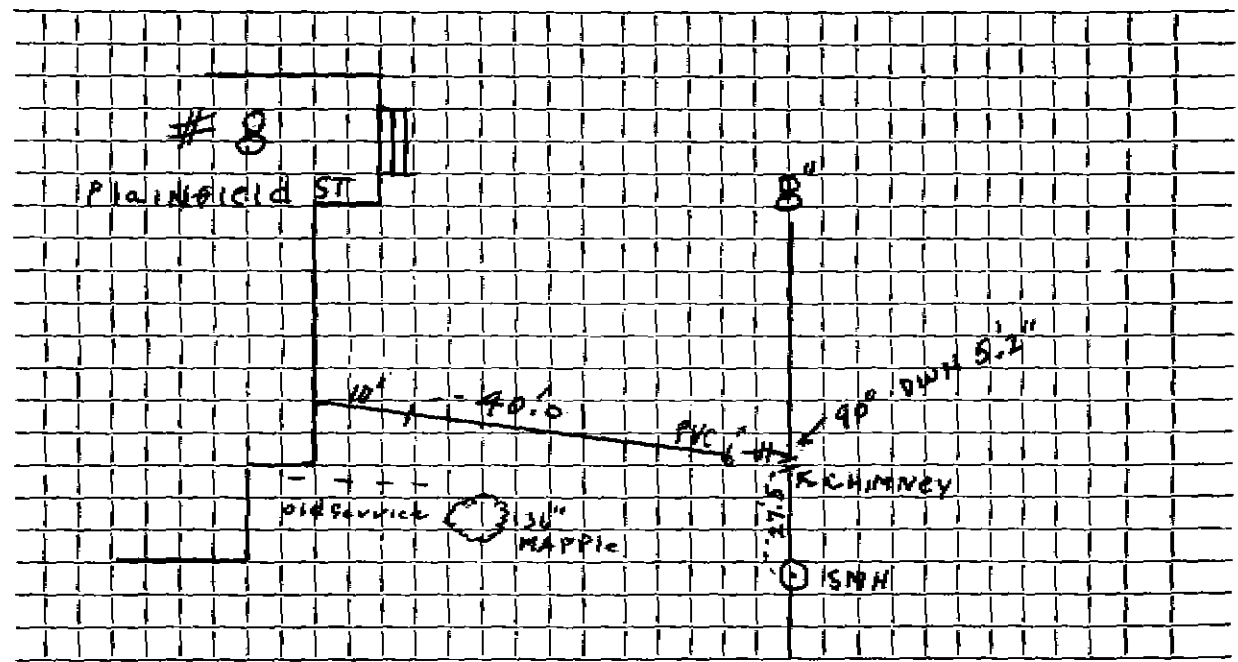

Connection made in ..... Street. Work completed 9/17/2004

Remarks: Renewed House To 90° E.L. Elbow Rotated To Clear Tree.