

Name

Service No.

Address 146 PLEASANT ST

RATONDI

Location

Kind of Pipe

Size

Size of Main

Repair ~~Renewal~~ New Service

Location

Date

Material

Amount

Total

Date

Amount

6/14/2017

6' SDR

6' MANHOLE

~ 6' DEEP

PRECAST, CONC.


6" CLEAN OUT

22", 45" BEND

DATE 6/2017

TOWN OF LEXINGTON — BOARD OF PUBLIC WORKS  
SEWER DIVISION

Sketch of Service Here

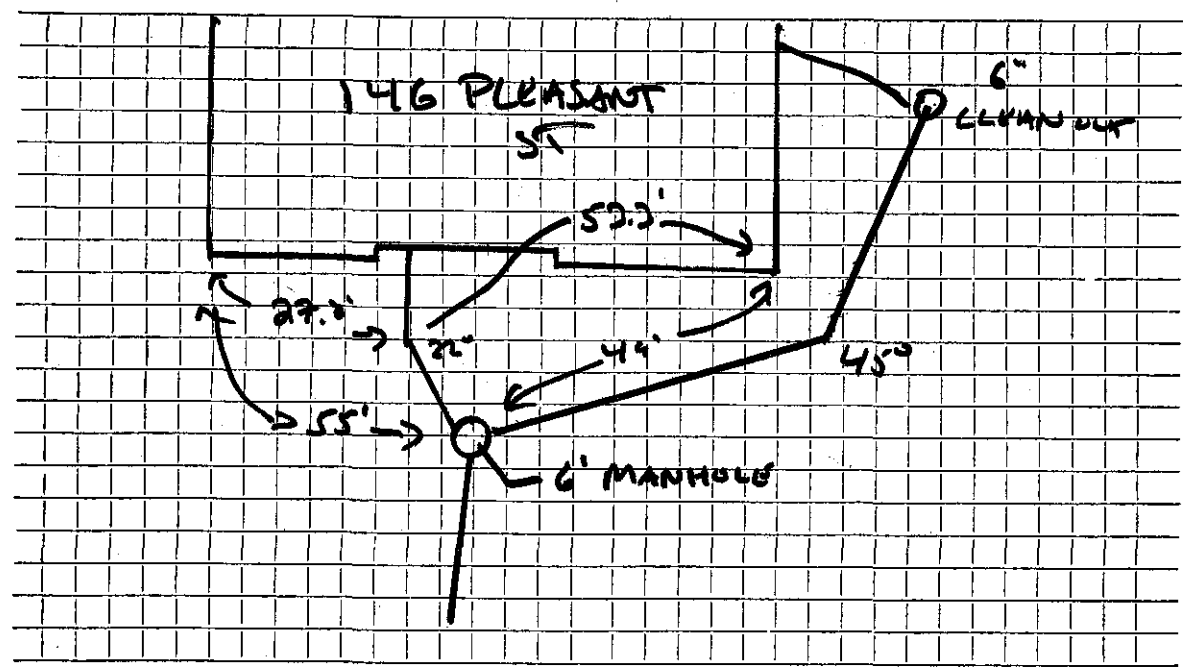

Connection made in ... PLEASANT ... Street.

Work completed ... ROTUNDI + SONS ...

Remarks: .....  
.....  
.....