




DATE \_\_\_\_\_

TOWN OF LEXINGTON — BOARD OF PUBLIC WORKS

SEWER DIVISION

Sketch of Service Here **102**

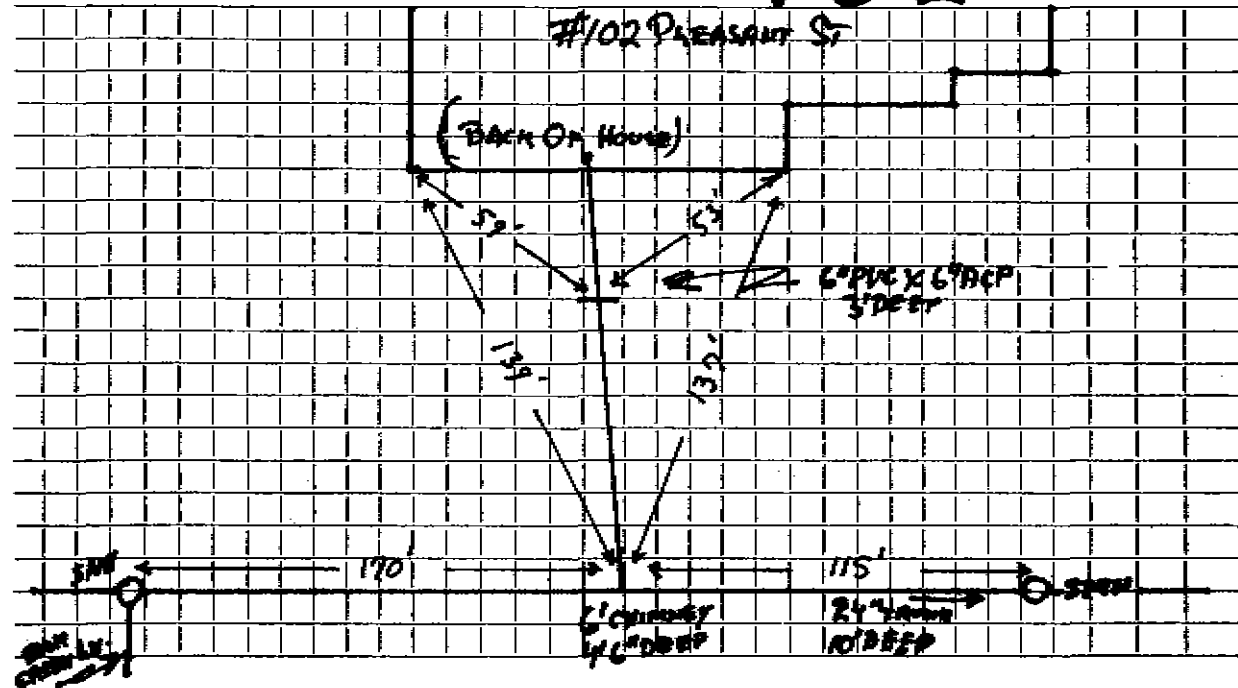

Connection made in ..... Street. Work completed .....

Remarks: **Original Service 8-9-63 (125'-6" Transite, 1-6x6" Tee.)**