

Name **Frank R. Strong**

Service No. **4**

Address **106 Pleasant Street**

**106 PLEASANT STREET**

Location

Kind of Pipe

Size **6"**

Size of Main **8"**

Repair—Renewal—New Service

Wot # **7027**

*Eastman Per Peter*

Location *Comm 2-26-62*

Date	Material	Amount	Total	Date	Amount
5/17/62	Labor	345 11		12-29-61	Deposit 780 00
	10% O.H.	34 51	379 62	3-20-62	Paid 32 50
	136' 6" Transite Pipe @ .78		106 08		782 50
	28 Ton Fill @ .70		19 60		
	20 1/2 Ton 3/4" Stone @ 1.50		30 75		
	105 Yds. Gravel @ 1.25		131 25		
	2 11 1/2" Bends @ 5.10		10 20		
	10 Hrs. Trucking @ 3.00		30 00		
	1 Hr. Trailer @ 3.00		3 00		
	12 Hrs. Pumping @ 1.00		12 00		
	5 Hrs. Compressor @ 3.00		15 00		
	2 Hrs. Loader @ 3.00		6 00		
	6 Hrs. Town Shovel @ 6.50		39 00		
			<u>782 50</u>		


*Bill 32 50*

DATE \_\_\_\_\_

TOWN OF LEXINGTON — BOARD OF PUBLIC WORKS  
SEWER DIVISION

Sketch of Service Here

106

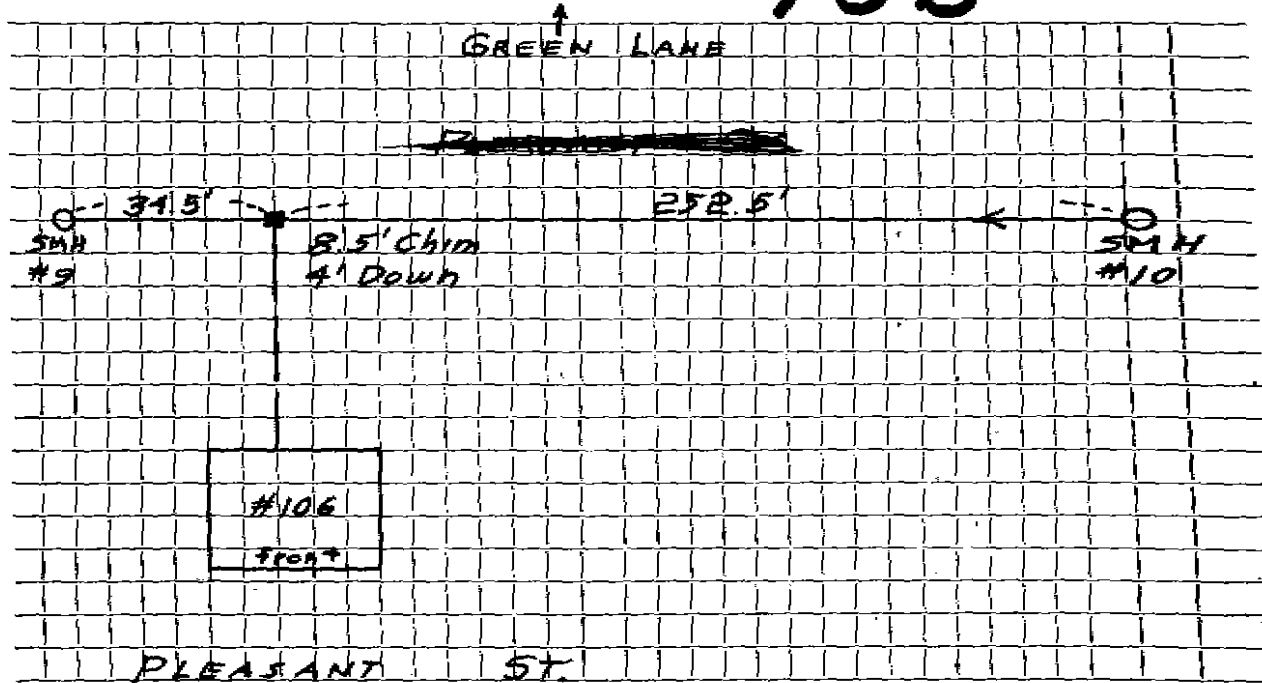

Connection made in ..... Street. Work completed .....

Remarks: .....

.....

.....