


DATE _____

TOWN OF LEXINGTON — BOARD OF PUBLIC WORKS
SEWER DIVISION

Sketch of Service Here

108

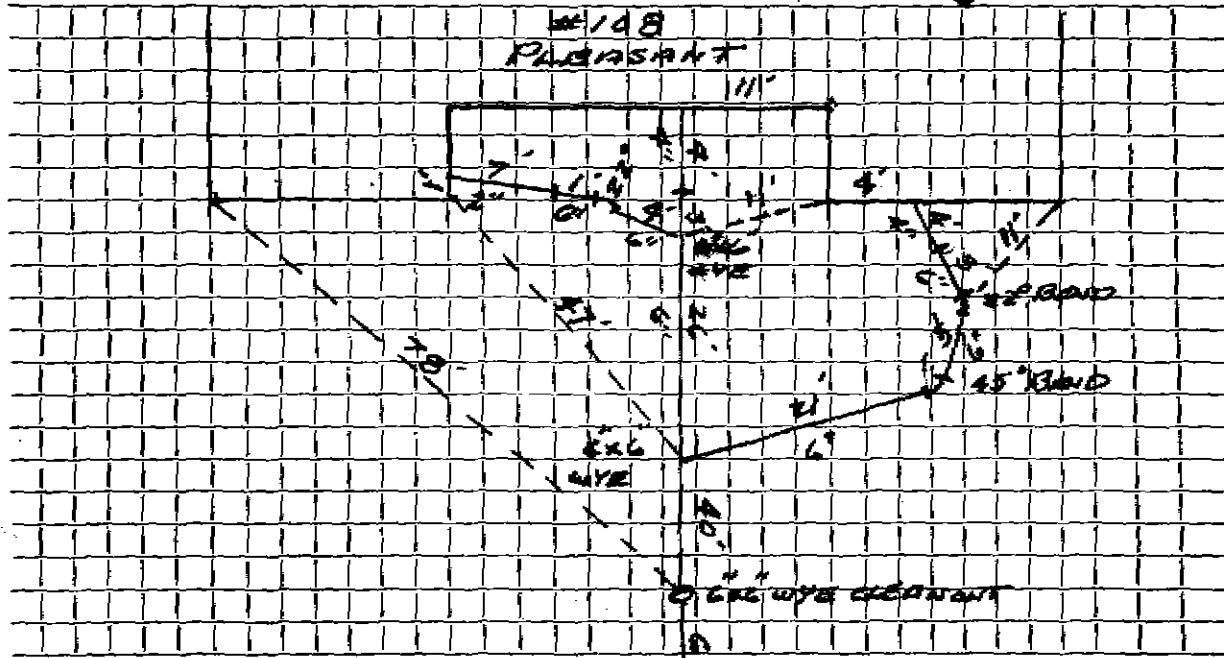

Connection made in EASEMENT Street. Work completed

Remarks: SERVICE @ REAR OF USE.

