

Name Frank R. Strong

Service No. 182

Address 110 Pleasant Street

Lot #4 110 Pleasant Street Location

Kind of Pipe

Size 6"

Size of Main 8"

~~Reconnect~~ New Service

W.O.# 7710

Location

Camm 1-14-63

| Date | Material | Amount | Total | Date | Amount |
|---------|---------------------------|--------|--------|---------|-------------------------|
| 1-13-62 | Labor | 89.61 | | 1-15-62 | Deposit 180.00 |
| 1-14-62 | " | 89.61 | 179.22 | 1-14-63 | Paid by W.H.#157 101.15 |
| | 10% O.H. | 17.92 | 197.14 | 2-27-64 | Paid 28.22 |
| | 40' 6" Transite pipe @.82 | | 32.80 | | 309.37 |
| | 6 3/4 ton 1" Stone @1.50 | | 10.12 | | |
| | 7 1/2 ton Gravel @.85 | | 6.16 | | |
| | 1 90° Transite Elbow | | 4.09 | | |
| | 1 6" Duplex Adapter | | 1.62 | | |
| | 1 11 1/4° Transite Elbow | | 2.35 | | |
| | 1 11 1/4° Transite Bend | | 4.09 | | |
| | 6 hrs. Town Shovel @6.50 | | 39.00 | | |
| | 4 hrs. Trucking @3.00 | | 12.00 | | |
| | | | 309.37 | | |


309.37

DATE _____

TOWN OF LEXINGTON — BOARD OF PUBLIC WORKS

SEWER DIVISION

Sketch of Service Here **110**

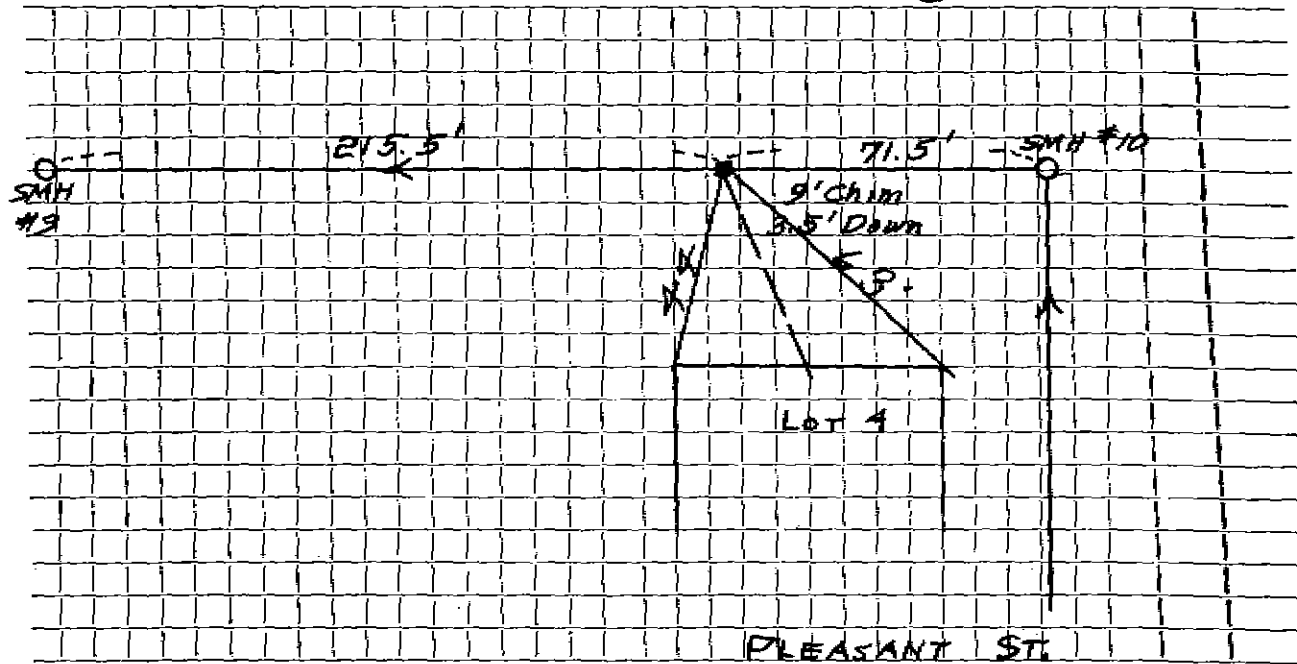

Connection made in Street. Work completed

Remarks:
.....
.....