

Name

Service No.

Address

112 Pleasant Street

112 PLEASANT STREET

Location

Kind of Pipe

Size 6"

Size of Main 8"

Repair—Renewal—New Service

Location

Date

Material

Amount

Total

Date


Amount

DATE _____

TOWN OF LEXINGTON — BOARD OF PUBLIC WORKS

SEWER DIVISION

Sketch of Service Here **112**

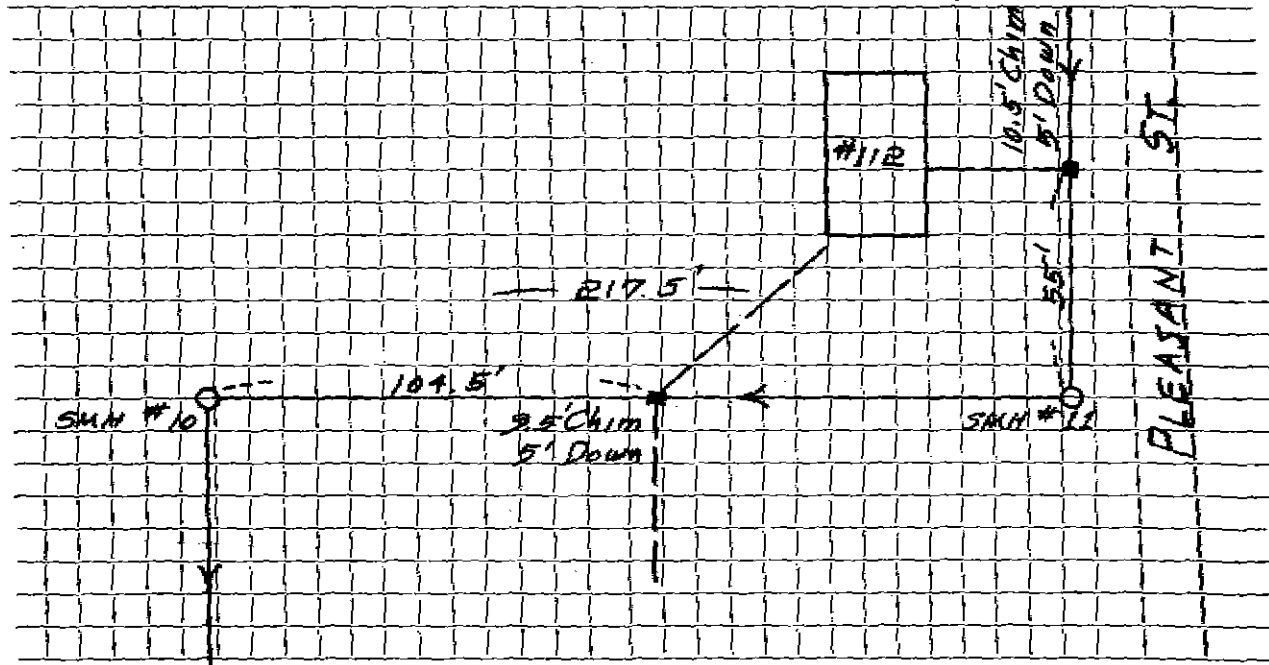


Connection made in Street. Work completed

Remarks:

.....
.....

DATE _____

TOWN OF LEXINGTON — BOARD OF PUBLIC WORKS
SEWER DIVISION

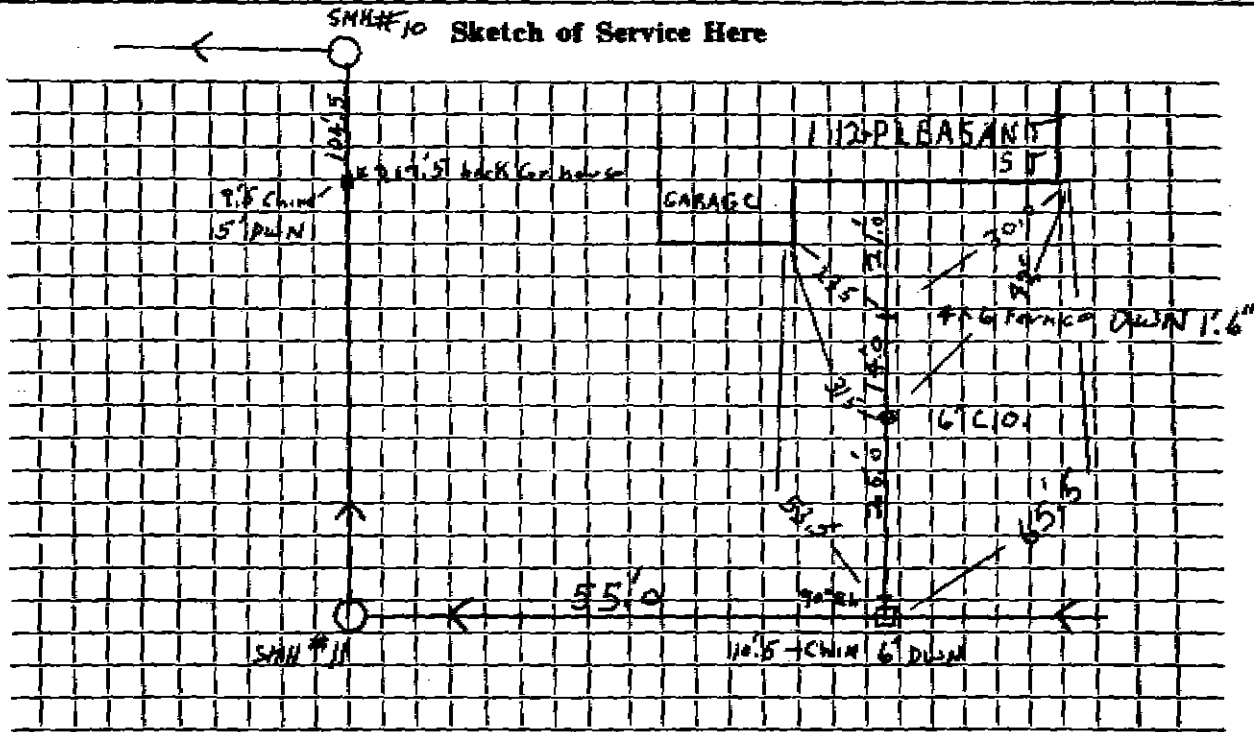

Connection made in Pleasant St. Street. Work completed 08/07 Bonzelli Co. S.

Remarks: Sewer MAIN Under curb. Stamp. F.A.M.S.P. D.W.N. 1.6"