

Service No. 36
 AUG 31 1978

Company: Health & Safety, Inc. (For Cities Dept. (pools))
 Address: 114 Pleasant Street

114 Pleasant Street Location

Size of Pipe: 6" Size of Main: 8"

Material: New Service H.O. #6341 Baller #3330 Location

Date	Material	Amount	Total	Date	Amount
6/5/78	Labor	45.15		2-5-78	Deposit
	10% O.H.	4.20	49.35		
10'	6" Transite @1.50		15.00		
1	5' x 6" Nipple @1.75		8.75		NON CHARGE
1	6" x 90° Elbow		5.70	6/5/78	Labor
1	6" Cap		4.20		
1	ton Gold Patch		15.90		
2	ton 3/4" Stone @ 4.00		8.00		
2	hrs. Trucking @3.00		6.00		
2	hrs. Backhoe @6.50		13.00		
	Ret. Top 9' x 14'		84.00		
			210.00		


DATE _____

TOWN OF LEXINGTON — BOARD OF PUBLIC WORKS

SEWER DIVISION

Sketch of Service Here **114**

Drawing
by
Debbie

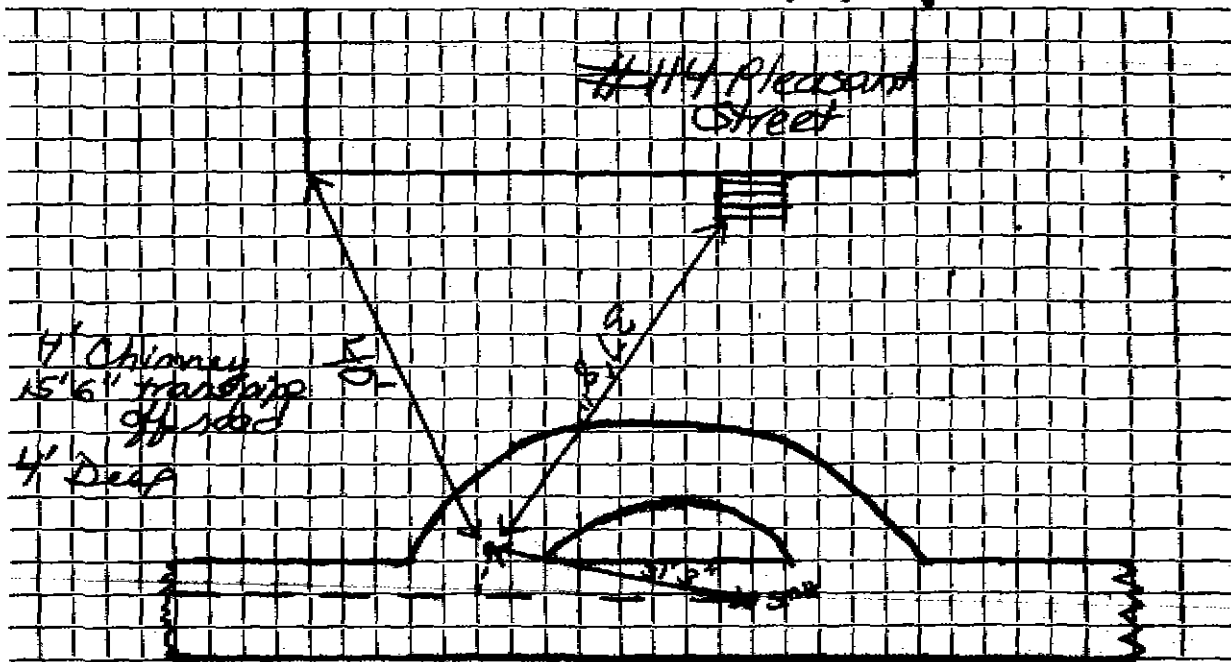

Connection made in Street. Work completed

Remarks: