

Name Fred Heinrich

Service No. 16

Address 136 Pleasant Street

JUN 18 1973

136 Pleasant Street

Location

Kind of Pipe

Size 6"

Size of Main 8"

Repair—Renewal—New Service Surianello #2268

Location


Date	Material	Amount	Total	Date	Amount
	13.5 ft. @ 4.00 per ft. installed by contractor		54.00	3/22/73	Deposit 54 00
4/17/73	26' 6" Transite pipe				
	15' 4" Cast Iron				

DATE _____

TOWN OF LEXINGTON — BOARD OF PUBLIC WORKS

SEWER DIVISION

Sketch of Service Here **136**

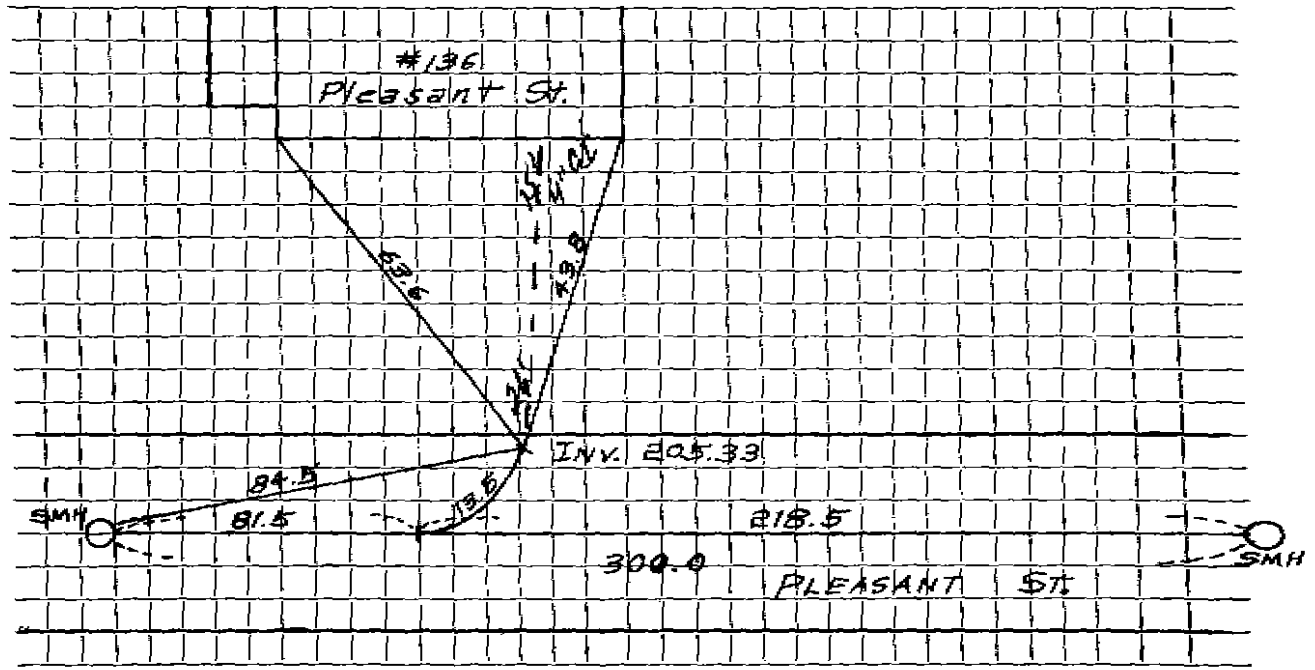

2-450 Connection made in Sweeps Street. Work completed

Remarks: 9' Deep