

Name ~~H. W. Green~~

Service No. 3

Address 148 Pleasant Street

148 PLEASANT STREET

Location

Kind of Pipe

Size 6"

Size of Main 8"

~~Repair - Renewal -~~ New Service

David Arsenault (16136) #4108

Location MAY 6 1985


Date	Material	Amount	Total	Date	Amount
	13.5 ft. @4.00 per ft. AC. installed by contractor		54.00	3/6/85	Deposit 54.00
11/85	60' 6" PVC				
	10' 4" Cast				
	6" Cast El Sweep				
	4" x 6" No Hub Increaser				
	AC to PVC Adaptor				

DATE _____

TOWN OF LEXINGTON — BOARD OF PUBLIC WORKS

SEWER DIVISION

Sketch of Service Here **148**

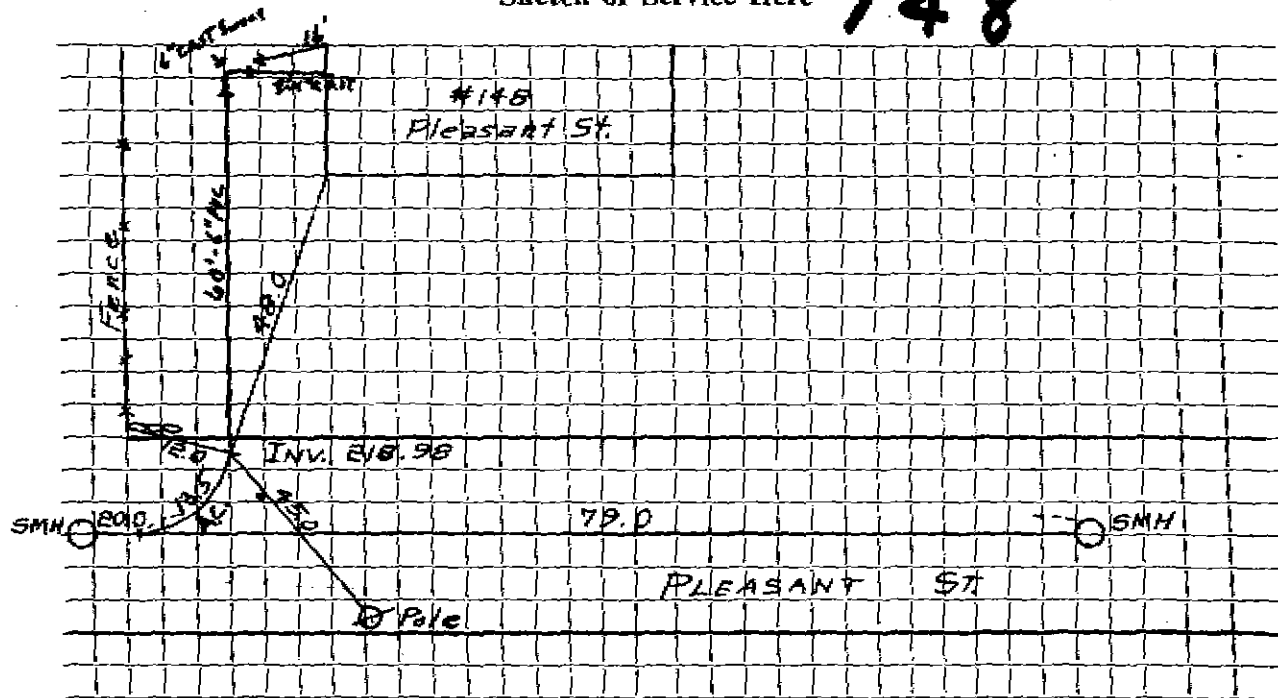

Connection made in Street. Work completed

Remarks: