

Name

Service No.

Address # 149 Pleasant St.

149 PLEASANT STREET

Location

Kind of Pipe

Size 6"

Size of Main 8"

Repair—Renewal—New Service

Location

Date

Material

Amount

Total

Date


Amount

DATE _____

TOWN OF LEXINGTON — BOARD OF PUBLIC WORKS

SEWER DIVISION

Sketch of Service Here **149**

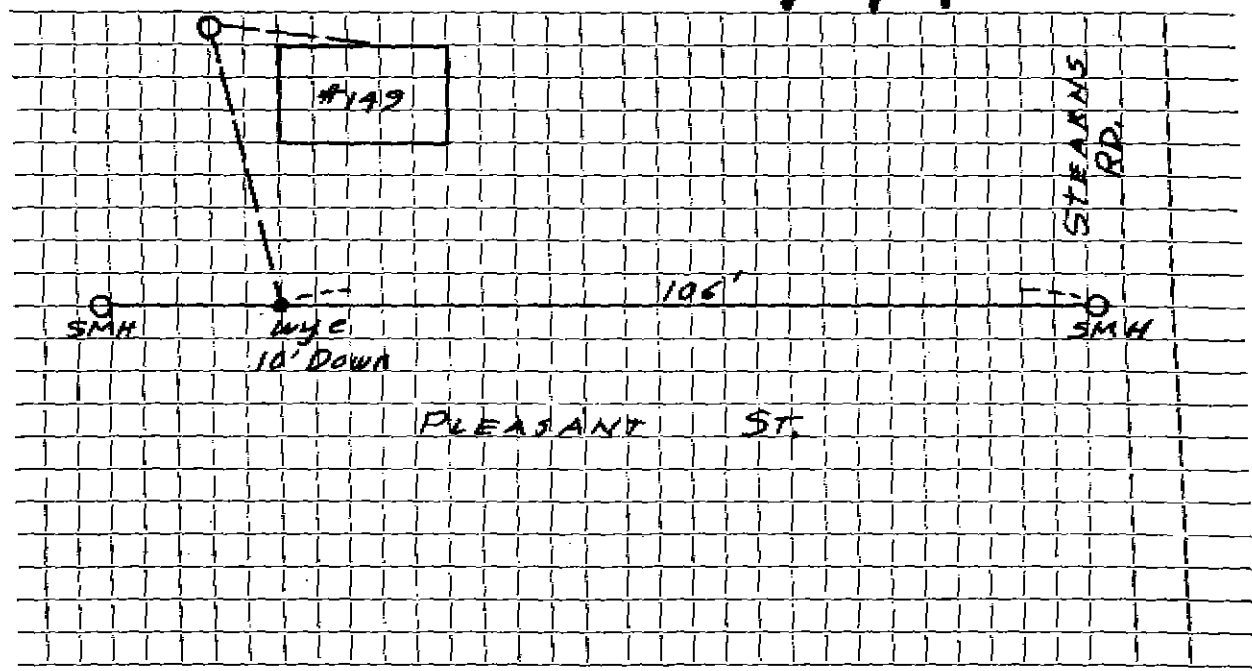


Connection made in Street. Work completed

Remarks:
.....
.....

DATE 12-11-97

TOWN OF LEXINGTON — BOARD OF PUBLIC WORKS SEWER DIVISION

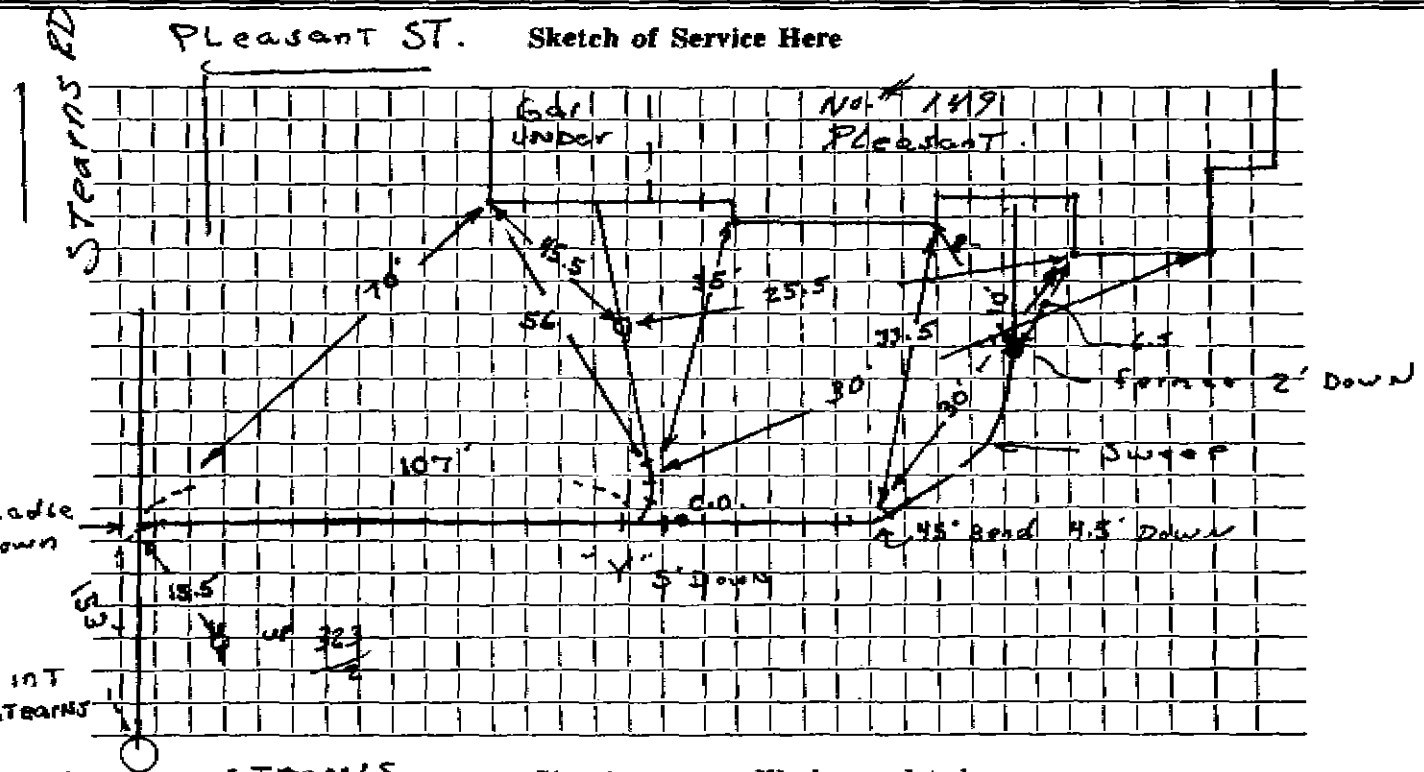

Connection made in STEARN'S Street. Work completed

Remarks: