


DATE 6-20-2013

TOWN OF LEXINGTON — BOARD OF PUBLIC WORKS
SEWER DIVISION

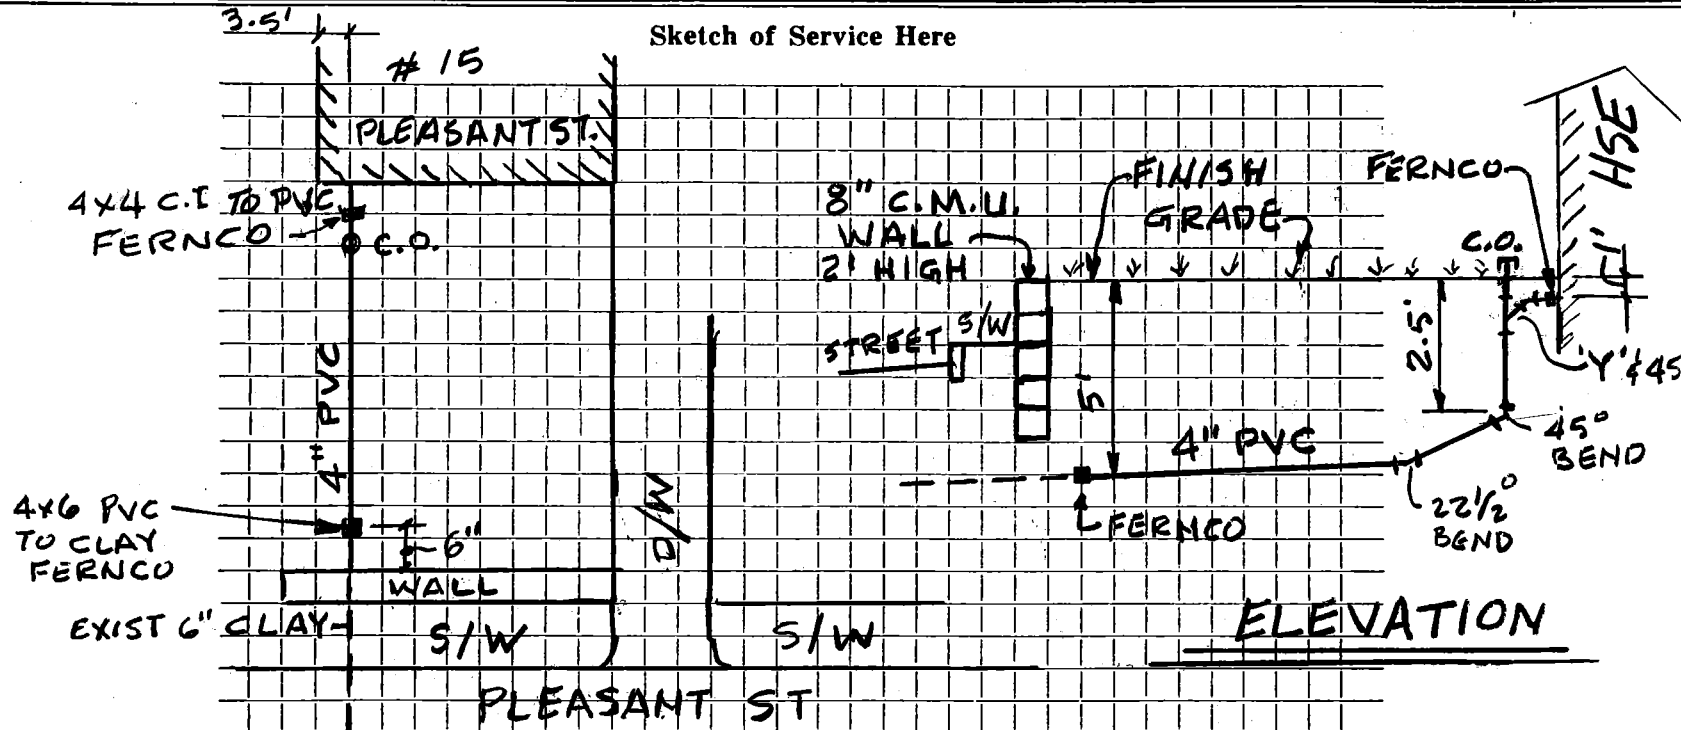

Connection made in ... PLEASANT Street. Work completed J.M. McLAUGHLIN

Remarks: REPLACE EXIST. 4\" CLAY SERVICE INSP. BY P.K.