

Service No.

Name

Address 150 Pleasant Street

150 PLEASANT STREET

Kind of Pipe

Size 6"

Size of Main 8"

Location

Location

Repair—Renewal—New Service

Date	Material	Amount	Total	Date	Amount
13.5	ft. @4.00 per ft. installed by contractor		54.00		


DATE \_\_\_\_\_

TOWN OF LEXINGTON — BOARD OF PUBLIC WORKS

SEWER DIVISION

Sketch of Service Here

150

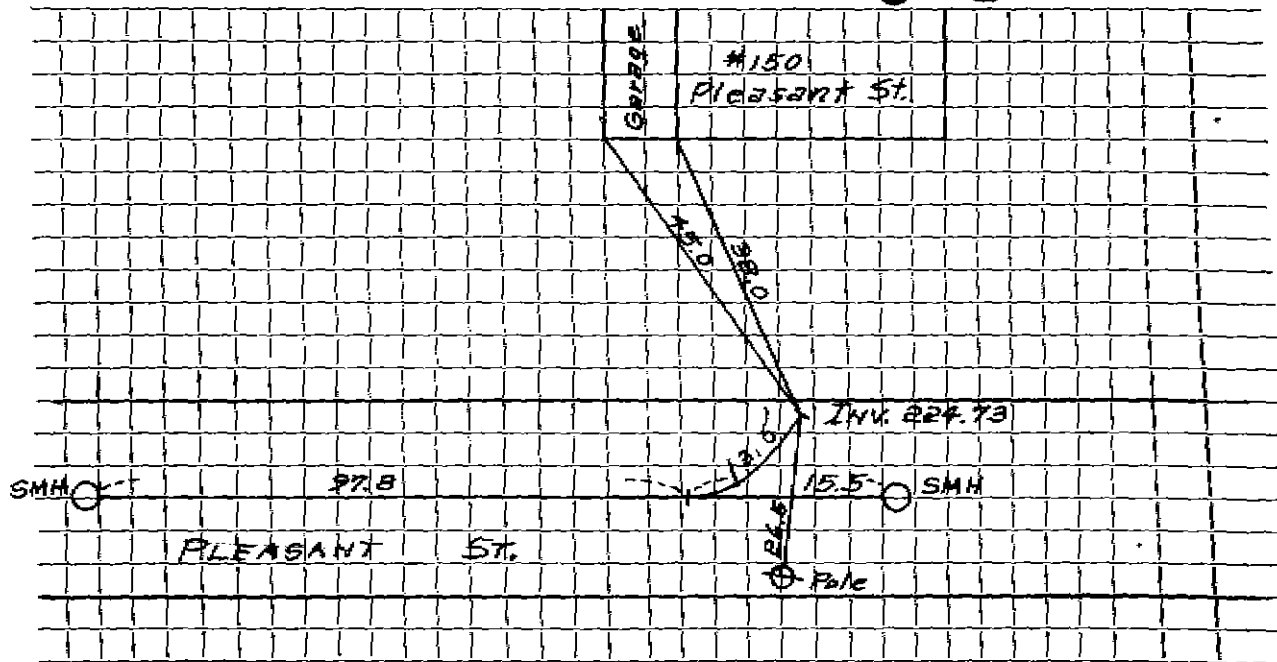

Connection made in ..... Street. Work completed .....

Remarks: .....

.....  
.....