

Name Myles Somers

Service No. 132

Address 151 Pleasant Street

151 PLEASANT STREET

Location

Kind of Pipe

Size 6"

Size of Main 8"

~~XXXXXXXXXXXX~~ New Service W.O. #3481


Location OCT 9 1967

Date	Material	Amount	Total	Date	Amount
1/8/66	Labor	86.80		10-19-66	125.00
1/9/66	"	24.80		3/19/66	140.67
2/16/66	"	31.85	143.45		265.67
	10% O.H.	14.35	157.80		
14'	6" Transite pipe @ .88		12.32		
2	1 1/2" Elbow @ 2.35		4.70		
2	1 1/2" Sweeps @ 2.35		4.70		
1	Adapter		1.62		
1	Collar		1.09		
1 1/2'	Bag Cement @ 1.55		.77		
10	Brick		.42		
5	Hrs. Bractor @ 6.50		32.50		
3	Hrs. Loader @ 4.00		12.00		
6	Hrs. Trucking @ 3.00		18.00		
2	Ton Hot Top @ 5.50		11.00		
1	Hr. Roller		3.00		
1/2	Hr. Backhoe @ 6.50		3.25		
1/2	Hr. Compressor @ 5.00		2.50		
			265.67		
1.28501 -2-66	53'	6" Transite pipe			Bill sent 142.67

DATE _____

TOWN OF LEXINGTON — BOARD OF PUBLIC WORKS
SEWER DIVISION

Sketch of Service Here **151**

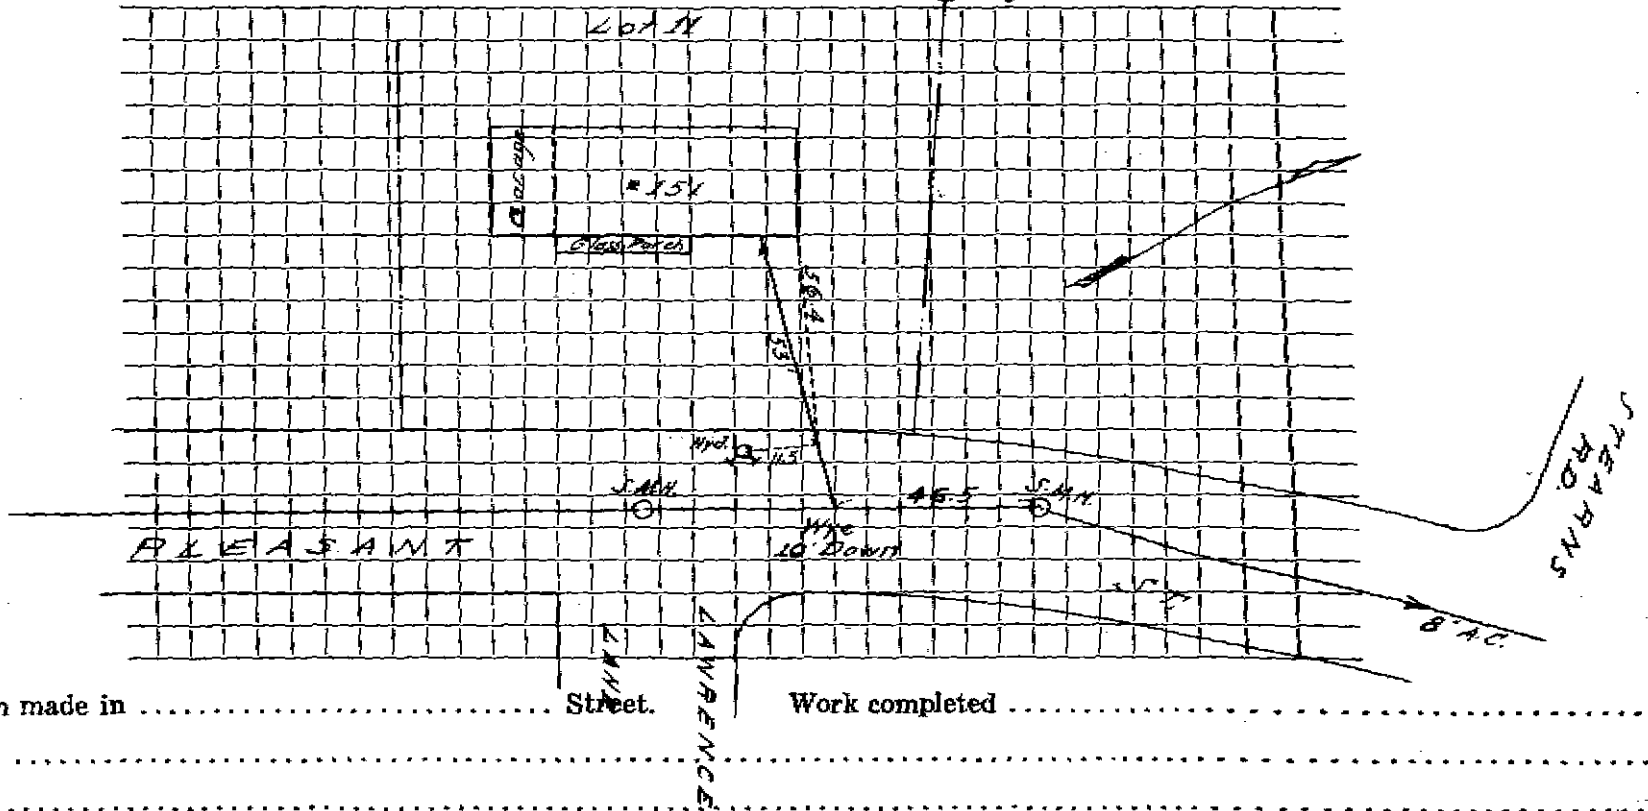

Connection made in Street. Work completed

Remarks:

.....

.....