

Name **George H. Stone**

Service No. **20**

Address **154 Pleasant Street**

154 PLEASANT STREET

Location

Kind of Pipe

Size **6"**

Size of Main **8"**

~~XXXXXXXXXXXX~~ New Service **WOT 7114**

Location **Com 12-16-62**

Date	Material	Amount	Total	Date	Amount
	18.5 ft. @4.00 per. ft. installed by contractor		74.00	4-4-62 1-3-63	350.00 7.48
0-23-62	Labor 72.88				357.48
0-24-62	" 72.88	145.76			
	10% O.H.	14.58	160.34		
	75 6" Transite Pipe @82		61.50		
	2 11 1/2° Transite Elbow @235		4.70		
	1 22 1/2° Transite Elbow		2.35		
	1 22 1/2° Transite Bend		4.09		
	5 Hrs. Town Shovel @6.50		32.50		
	6 Hrs. Trucking @3.00		18.00		
			357.48		


DATE _____

TOWN OF LEXINGTON — BOARD OF PUBLIC WORKS

SEWER DIVISION

Sketch of Service Here

154

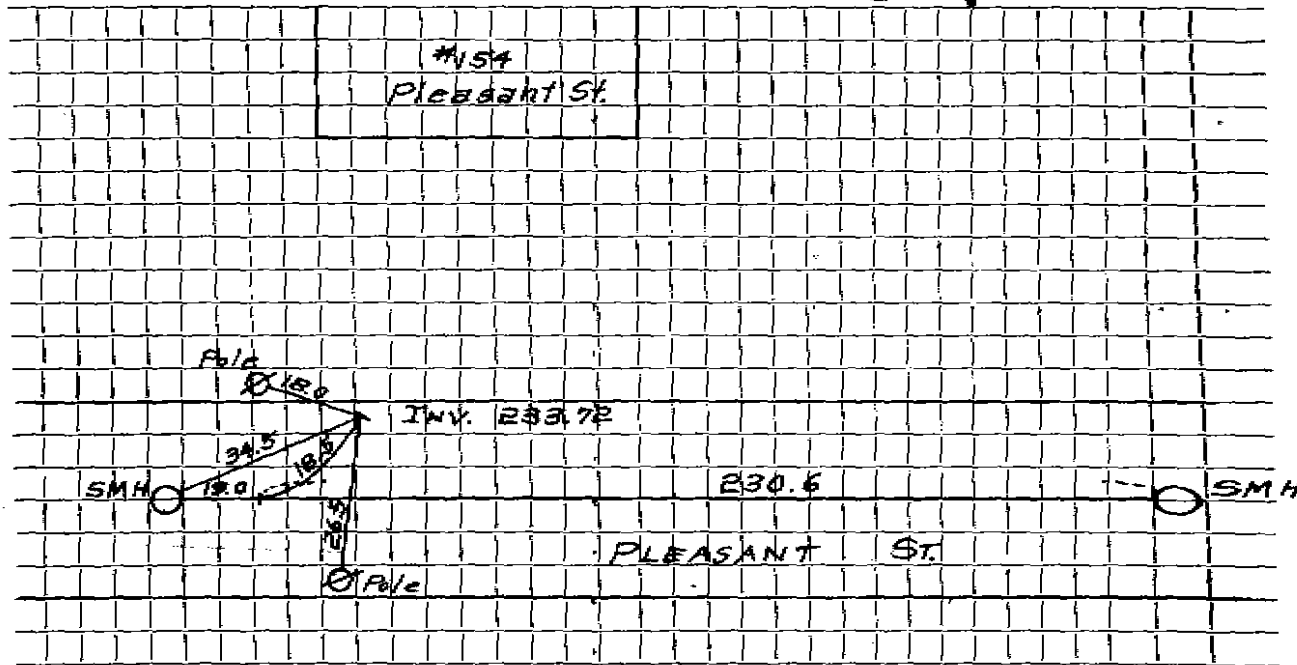

Connection made in Street. Work completed

Remarks: