

Name John Oberto

Service No. 3

Address ~~156 Pleasant Street~~

JUN 18 1973

156 PLeasant Street

Location

Kind of Pipe

Size 6"

Size of Main 8"

~~REPAIR WORK~~ - New Service Trebina Const. Co. #2253

Location

Date	Material	Amount	Total	Date	Amount
	13.5 ft. @4.00per ft. installed by contractor		54.00	2-28-73	54.00
4-3-73	51' 6" transite				
	10' 4" C. I.				


DATE _____

TOWN OF LEXINGTON — BOARD OF PUBLIC WORKS

SEWER DIVISION

Sketch of Service Here

156

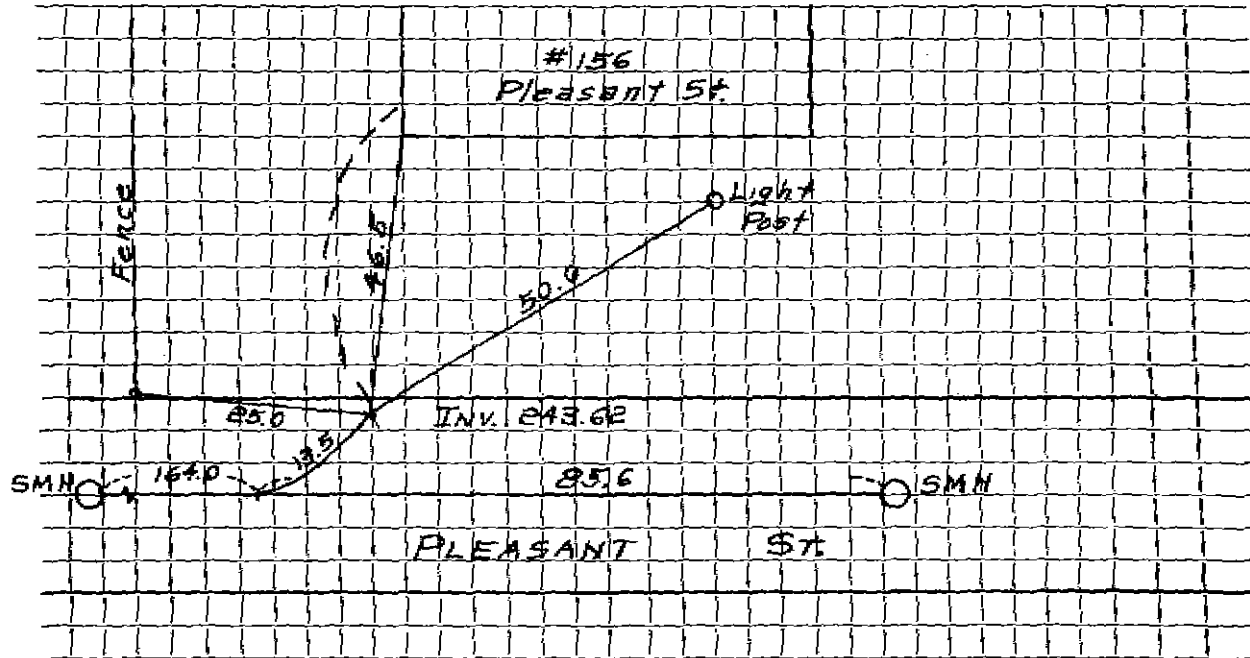

Connection made in Street. Work completed

Remarks:

.....

.....