

Name John Buscone

Service No. 121

Address 159 Pleasant Street

159 PLEASANT STREET

Location

Kind of Pipe

Size 6"

Size of Main 8"

Repair ~~Renewal~~ — New Service W.O # 7010 Trebino #1498

Location DEC 22 1969

Date	Material	Amount	Total	Date	Amount
0/27/69	Labor	154 64		11-21-69	210 00
1/10/69	"	16 61	171 25	1-19-70	14 53
	10 % O.H.		17 13	2-18-70	103 18
	20' Transite pipe .88		17 60		
	1 90° Elbow		4 09		
	1 6" Nipple		4 91		
	1 6X8 Saddle		5 50		
	1/2 Bag Cement 1.55		78		
	6 Brick .07		42		
	1 Yd. Loam		3 50		
	Patching		48 78		
	3 Hrs. trucking 3.00		9 00		
	1/2 " 1.50		75		
	1 " compressor		5 00		
	1 " loader		4 00		
	6 " shovel 6.50		39 00		
			327 71		
-28-69	65 6" Transite pipe				
	20 4" Cast Iron pipe				Bill sent 103.18


DATE _____

TOWN OF LEXINGTON — BOARD OF PUBLIC WORKS

SEWER DIVISION

Sketch of Service Here

159

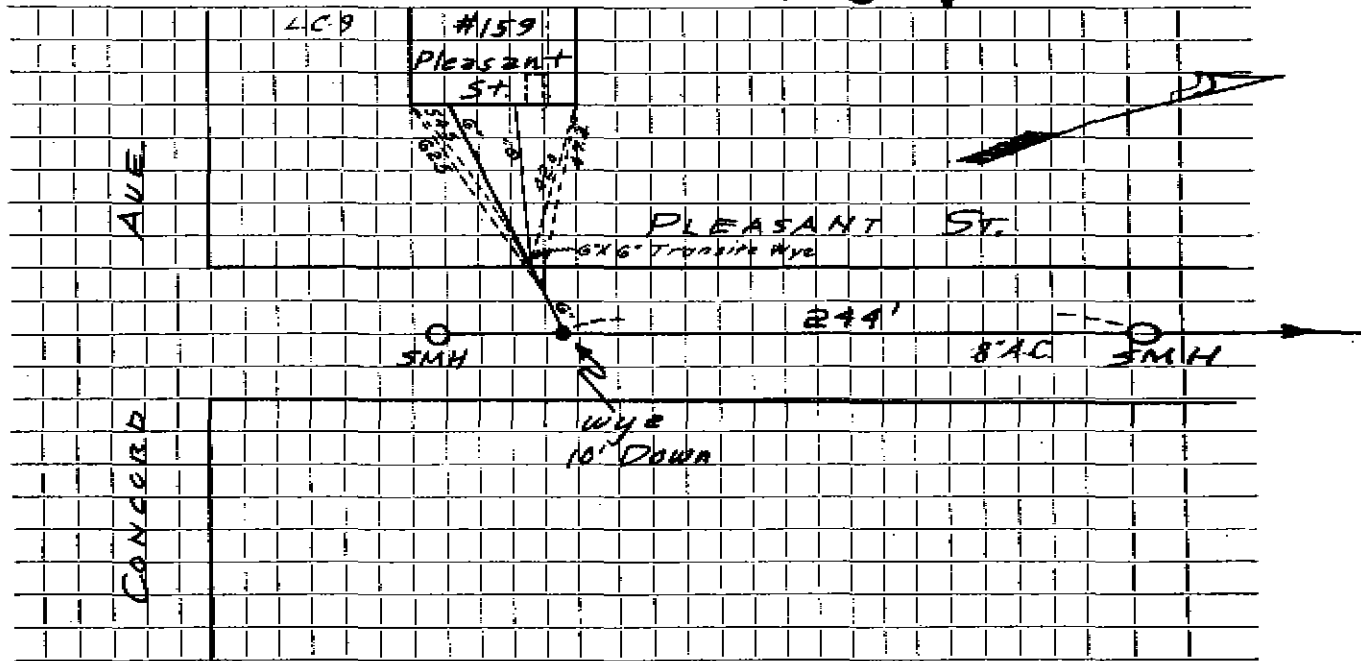

Connection made in Street. Work completed

Remarks:

.....

.....