






DATE \_\_\_\_\_

TOWN OF LEXINGTON — BOARD OF PUBLIC WORKS

SEWER DIVISION

Sketch of Service Here **21**

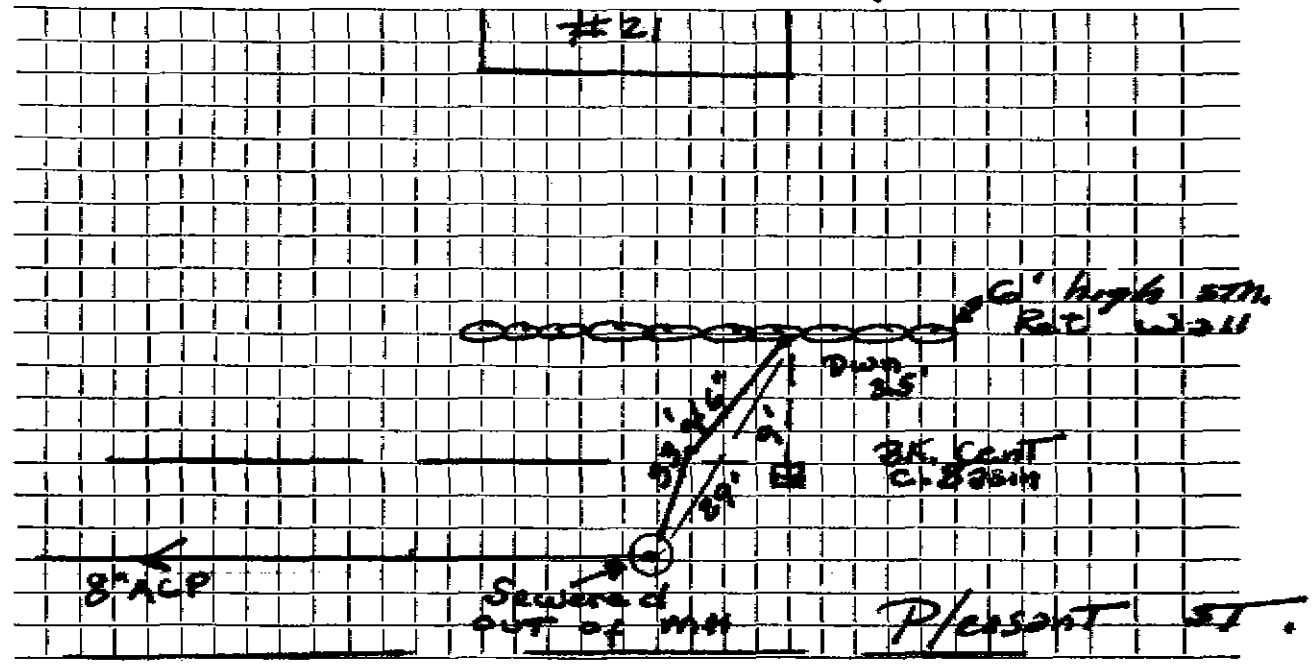


Connection made in Pleasant Street. Work completed .....

Remarks: .....

DATE 4/5/00

TOWN OF LEXINGTON — BOARD OF PUBLIC WORKS  
SEWER DIVISION

Sketch of Service Here

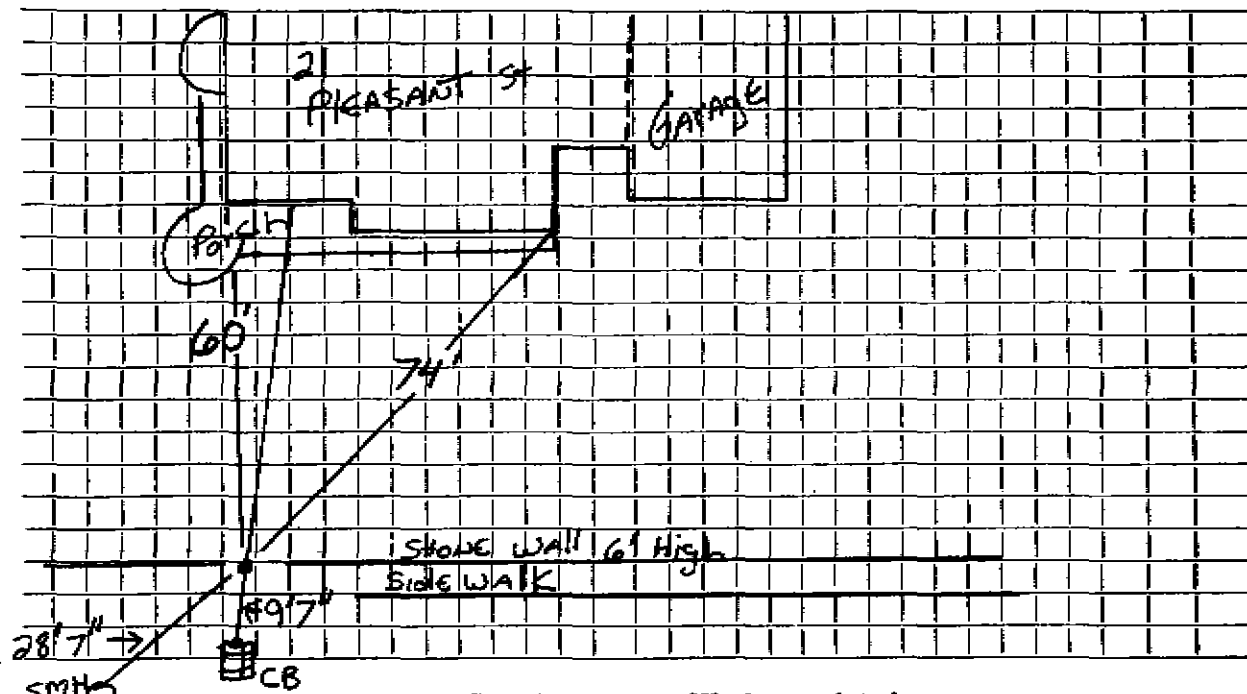

Connection made in SMHO Street. Work completed

Remarks: SEWER stub 3' below sidewalk