


DATE _____

TOWN OF LEXINGTON — BOARD OF PUBLIC WORKS

SEWER DIVISION

23

Sketch of Services Here

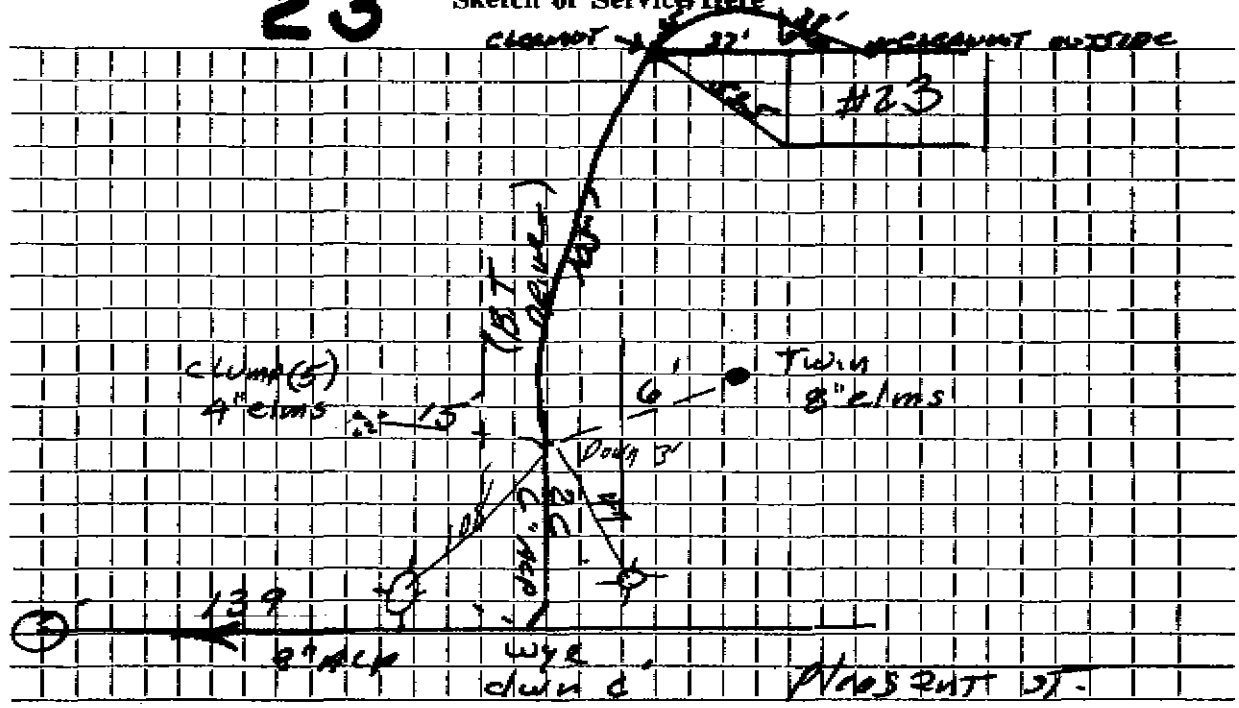

Connection made in PLEASANT Street. Work completed

Remarks: