


41 Pleasant Street.
 SEWER SERVICE FOR BARN
 TOWN OF LEXINGTON — BOARD OF PUBLIC WORKS

DATE _____

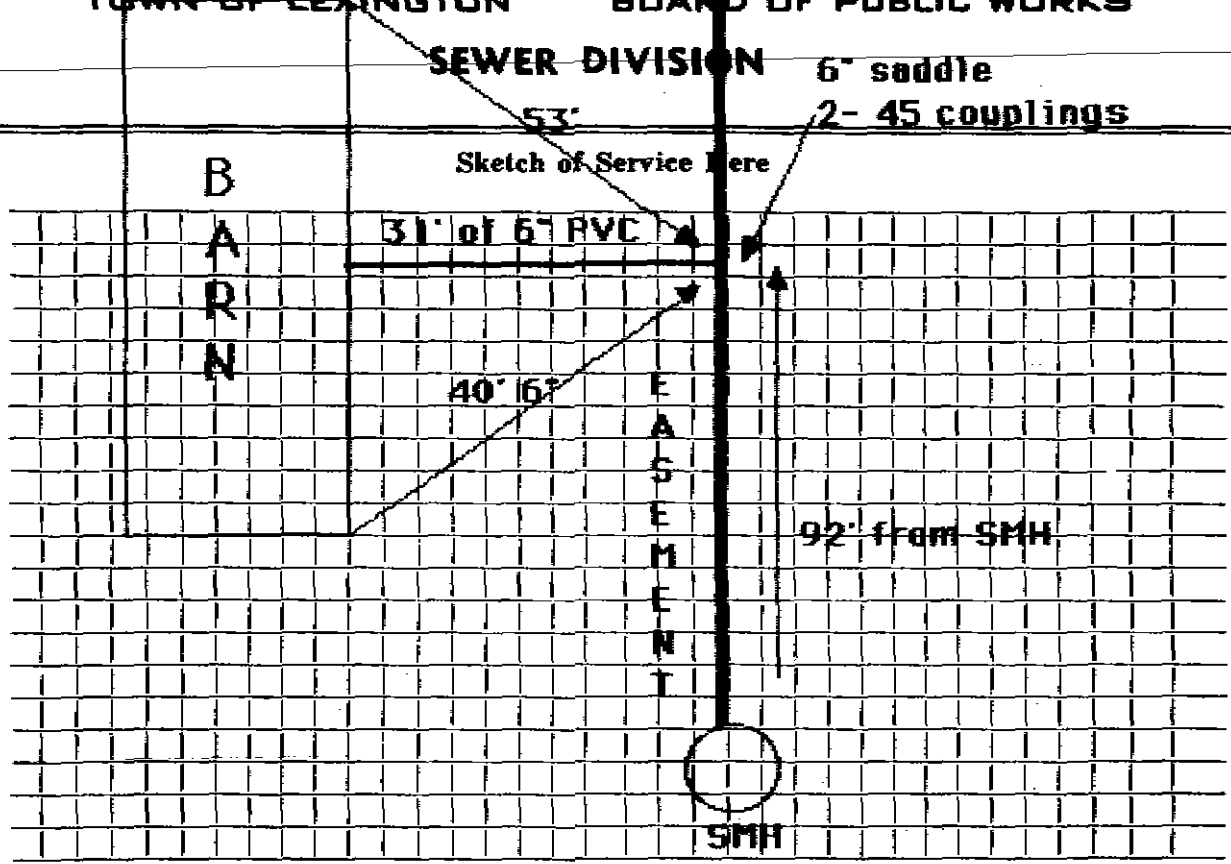


Connection made in Street. Work completed

Remarks:

DATE _____

TOWN OF LEXINGTON — BOARD OF PUBLIC WORKS
SEWER DIVISION

Sketch of Service Here

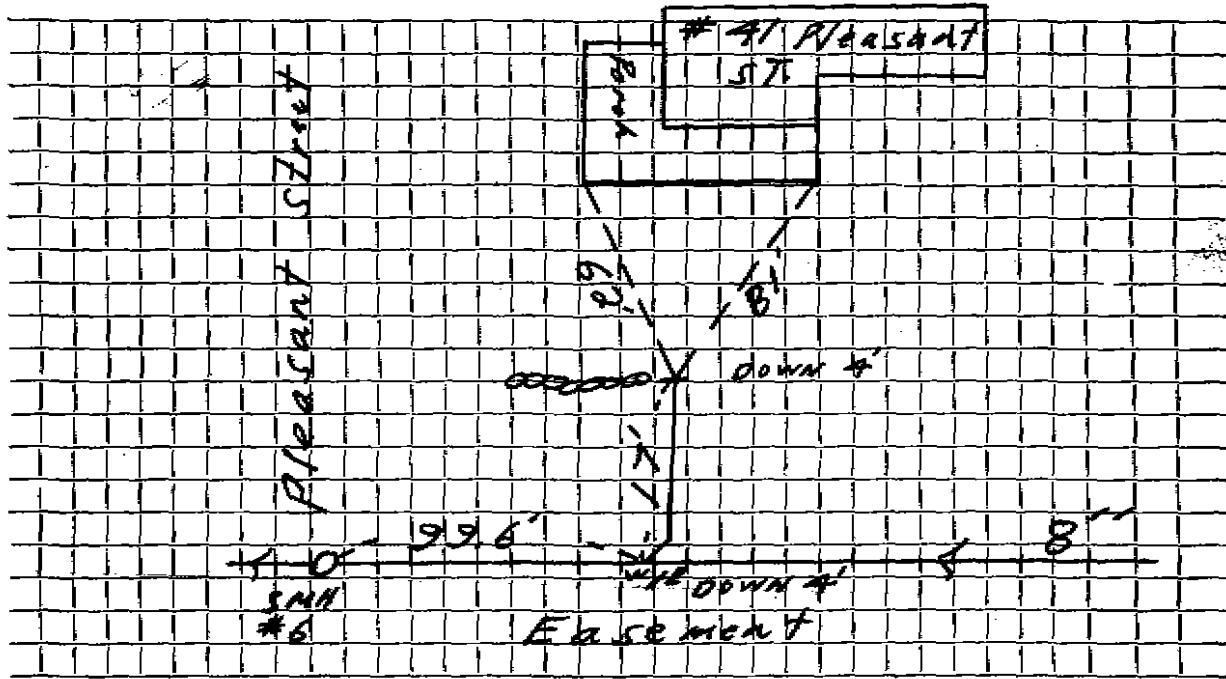

Connection made in Easement ~~Street~~ Work completed

Remarks:
.....
.....